



**6 BASEMENT KEY PLAN**  
A2B 1" = 80'-0"

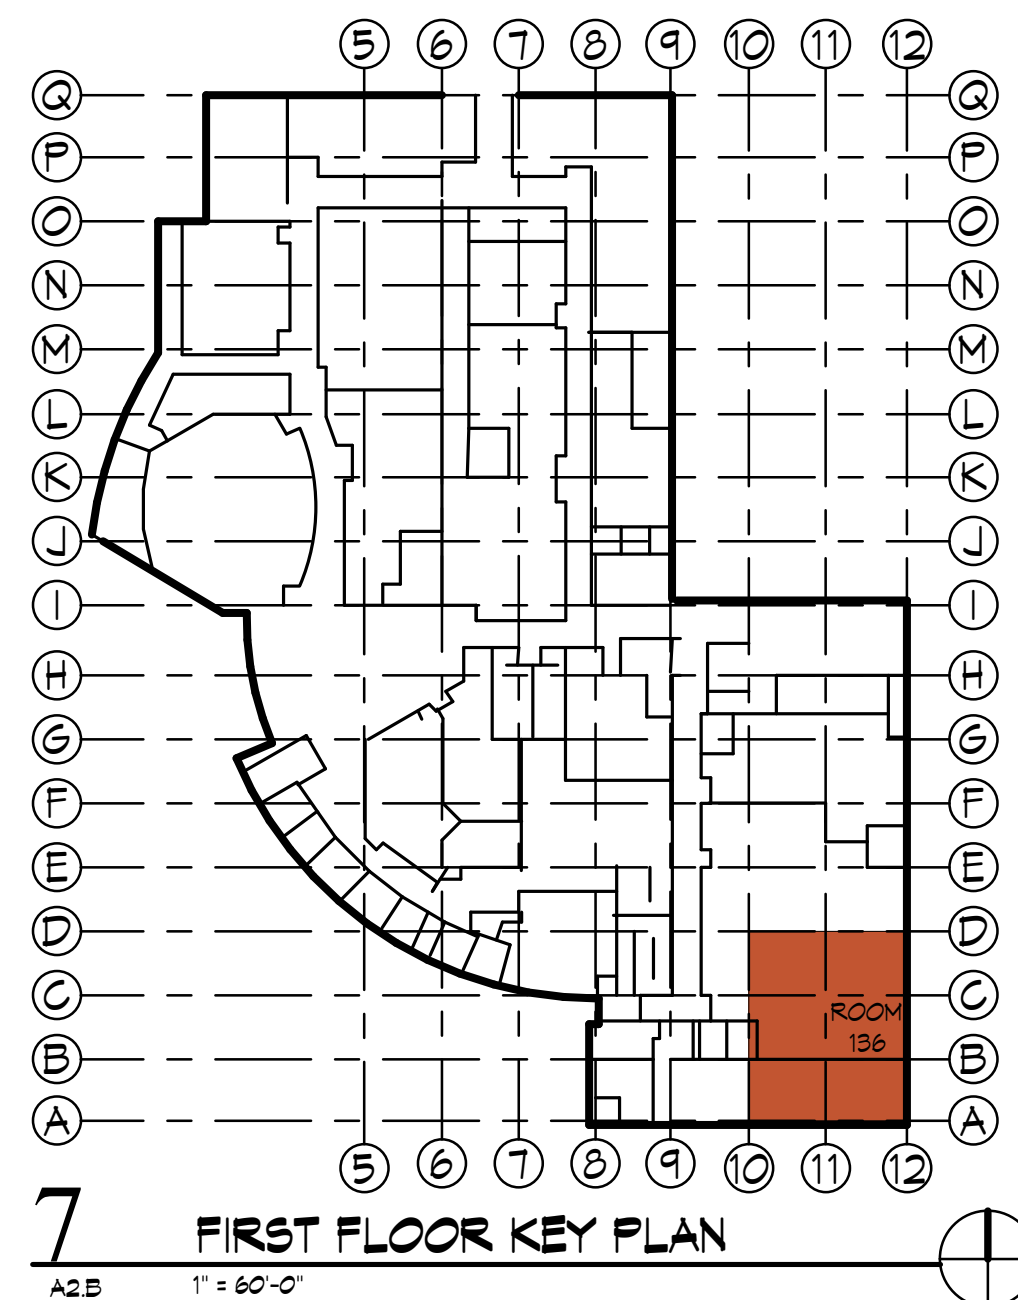


**7 FIRST FLOOR KEY PLAN**  
A2B 1" = 80'-0"


Mark	TYPE MARK	INDEX
GB1	GB1 - NANOPRAZOR	1
GB2	GB2 - MTL DEPOSITION & LITHO DEV.	2
GB3	GB3 - 2D PREP & FAB	3
GB4	GB4 - IN-SITU CHARACTERIZATION	4
OT01	OPTICAL TABLE 1 - CHARACTERIZATION	10
OT02	OPTICAL TABLE 2 - OPTICOOOL	11
OT03	OPTICAL TABLE 3 - MI S100 CRYOSTAT	12
OT04	OPTICAL TABLE 4 - LOW TEMP AFM & NANO OPTICAL MICROSCOPE	13
M01	OPTICOOOL TOWER	15
M02	OPTICOOOL CABINET	16
M03	OPTICOOOL CRYOSTAT HELIUM COMPRESSOR	17
M04	OPTICOOOL CRYOSTAT CHILLER	18
M05	M1 CRYOSTAT	20
M07	M1 COMPRESSOR	22
M08	AFM COMPRESSOR	24
M09	AFM FUTURE CHILLER	25
M10	FUTURE COMPRESSOR	30
M11	EVAPORATOR FOR THE GLOVEBOX	33
M12	NEW FUME HOOD	35
M13	RELOCATED FUME HOOD	35

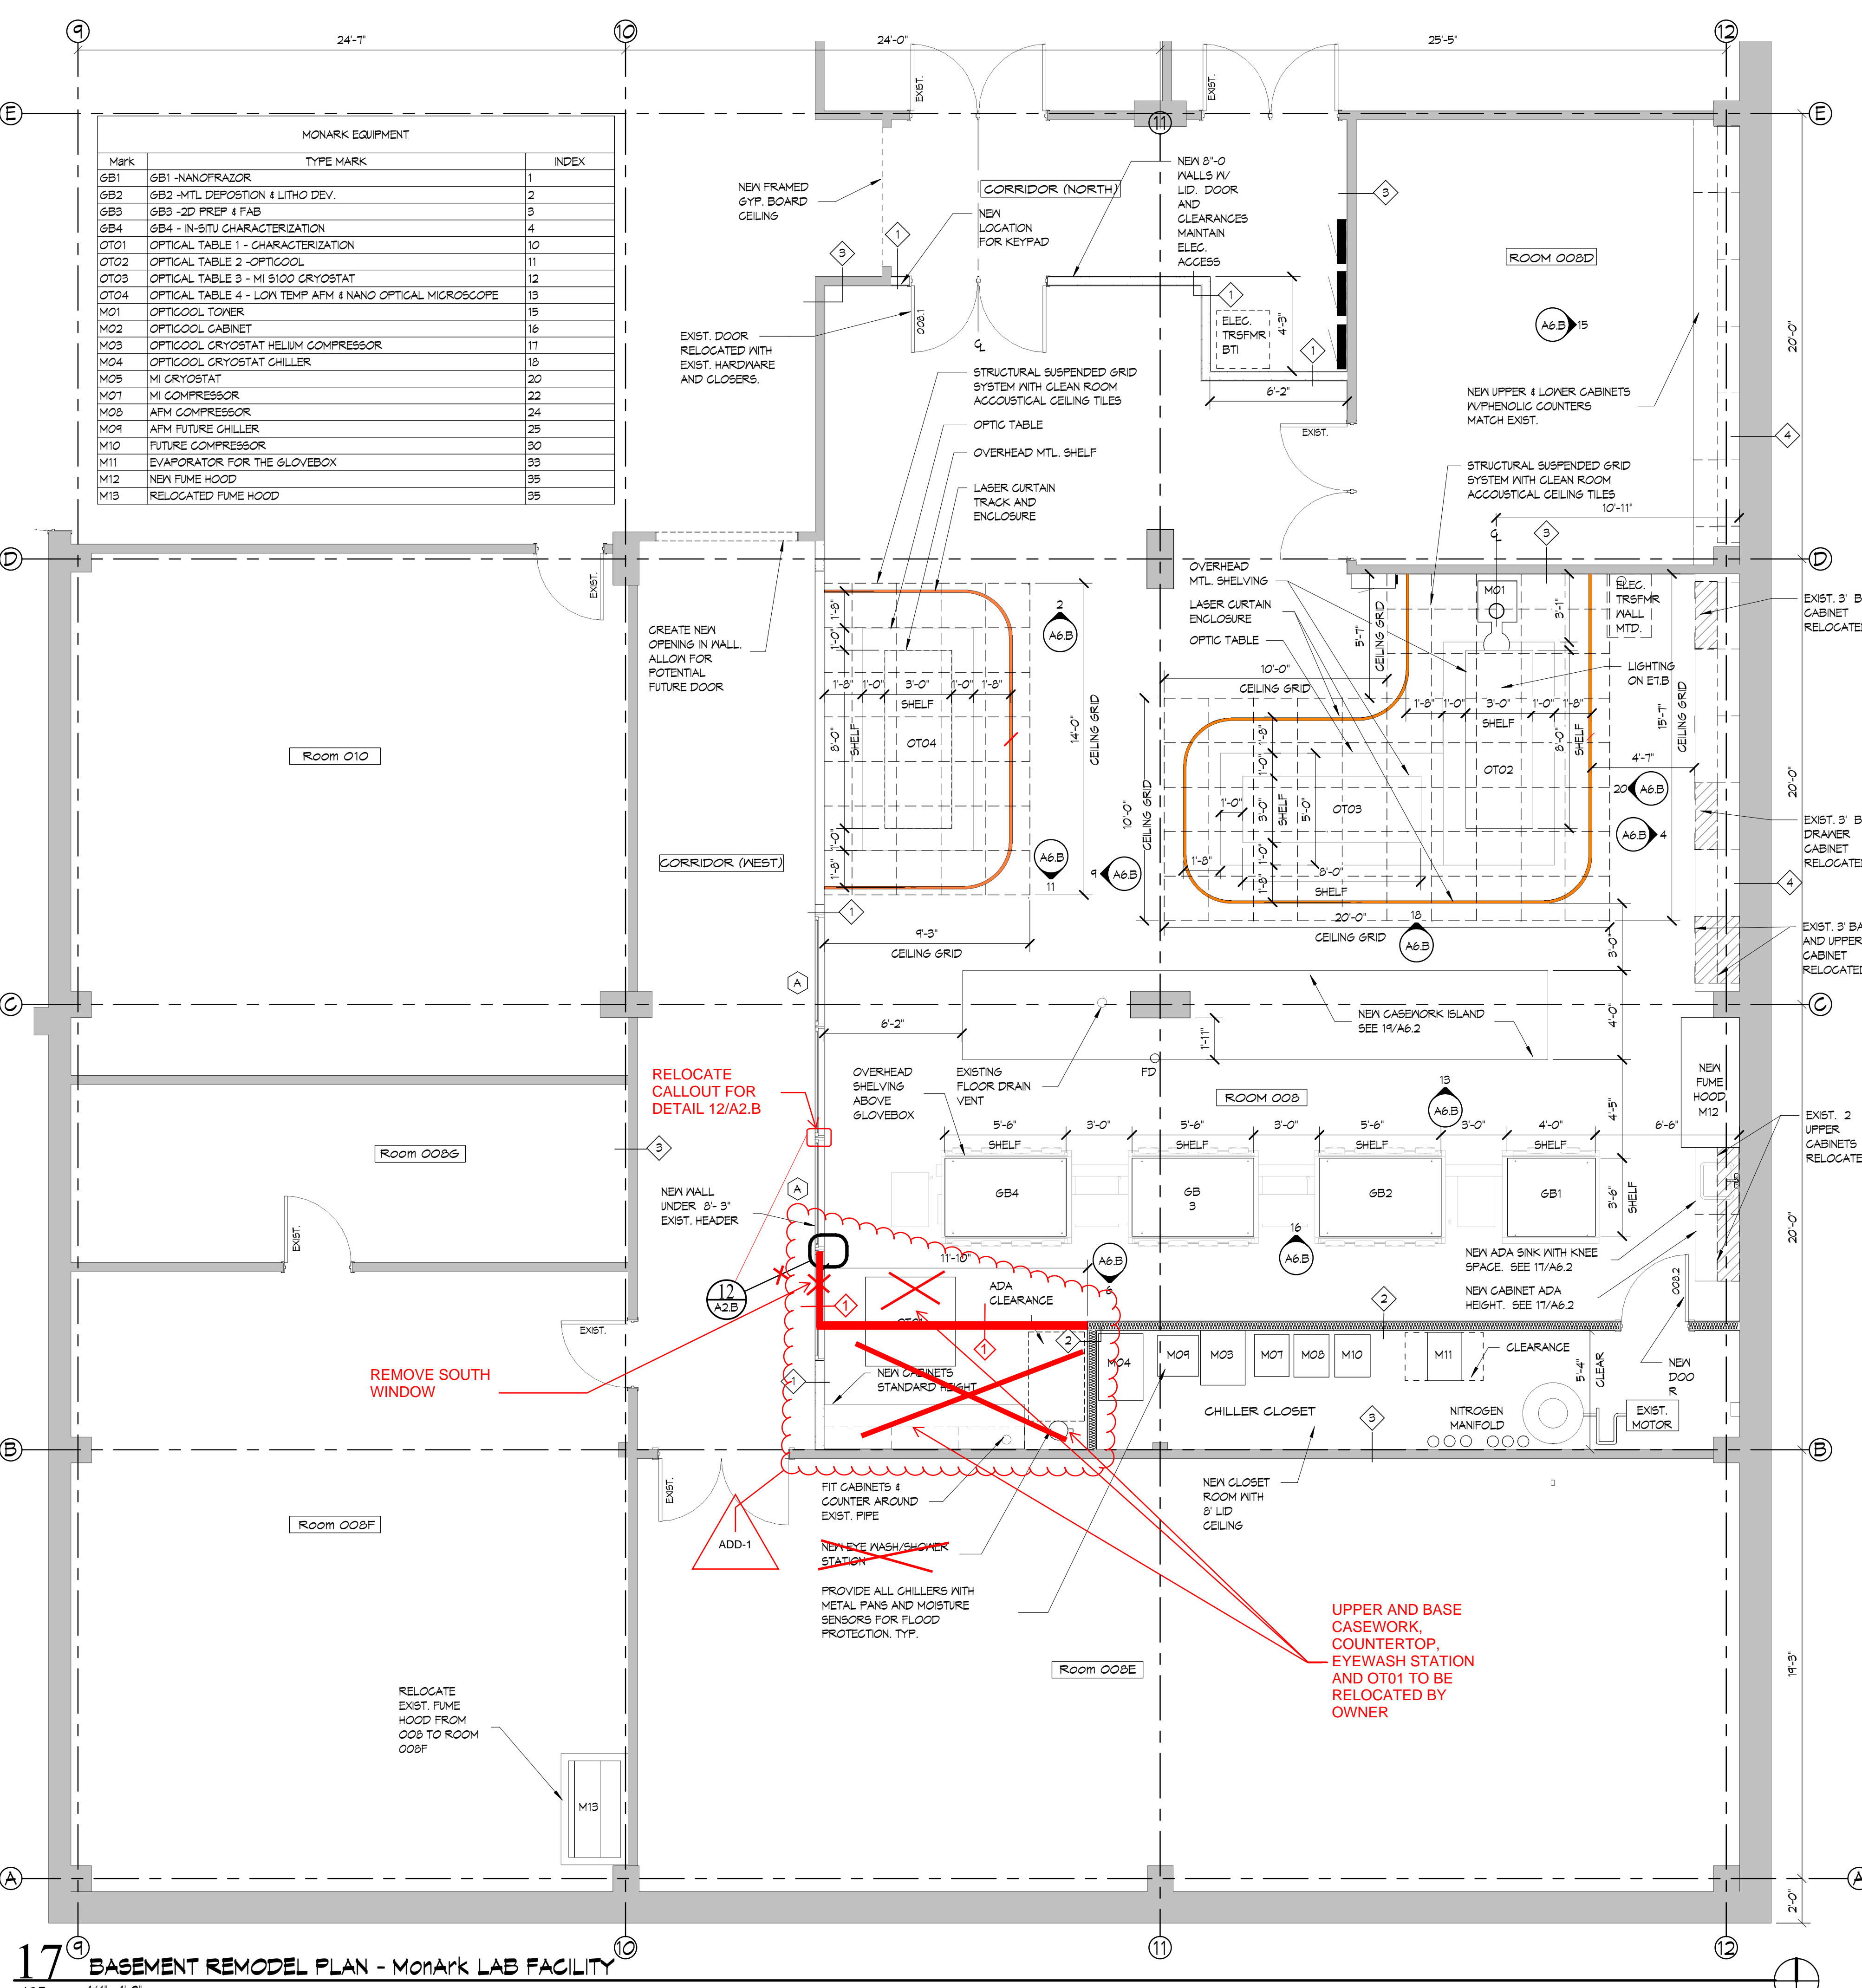


**17 BASEMENT REMODEL PLAN - MonArk LAB FACILITY**  
A2B 1/4" = 1'-0"

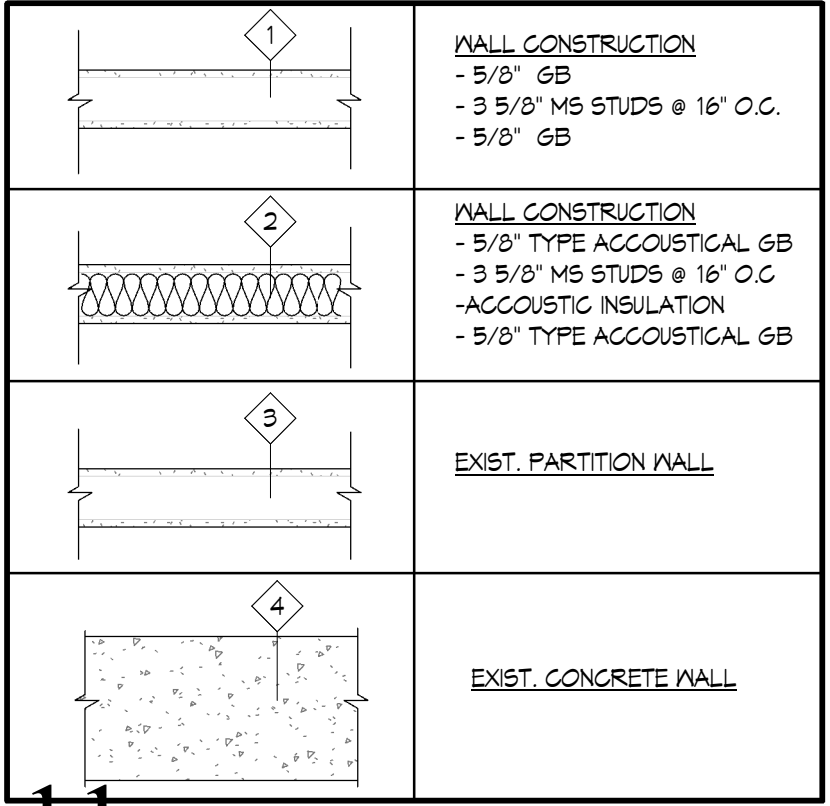


**11 WALL TYPES**  
A2B 3/4" = 1'-0"

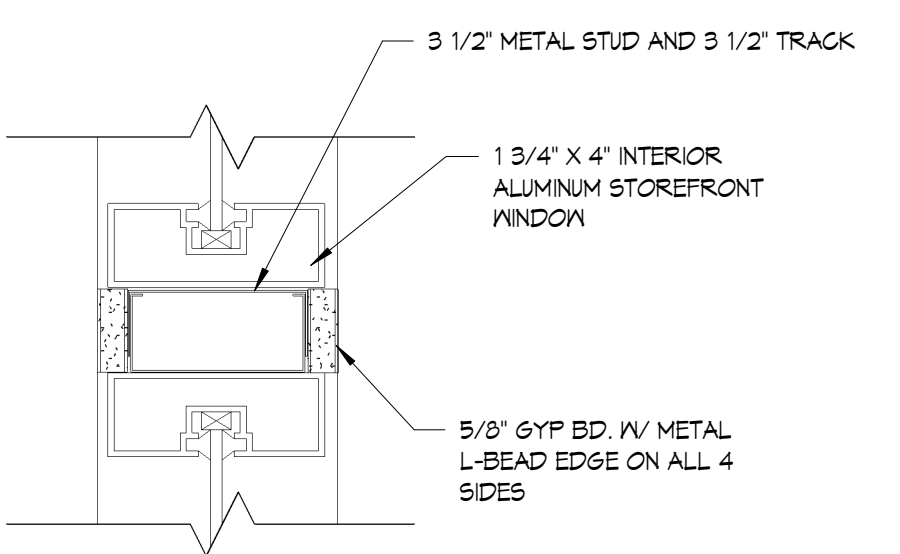

**12 PLAN DETAIL @ WINDOW FRAMING**  
A2B 5" = 1'-0"

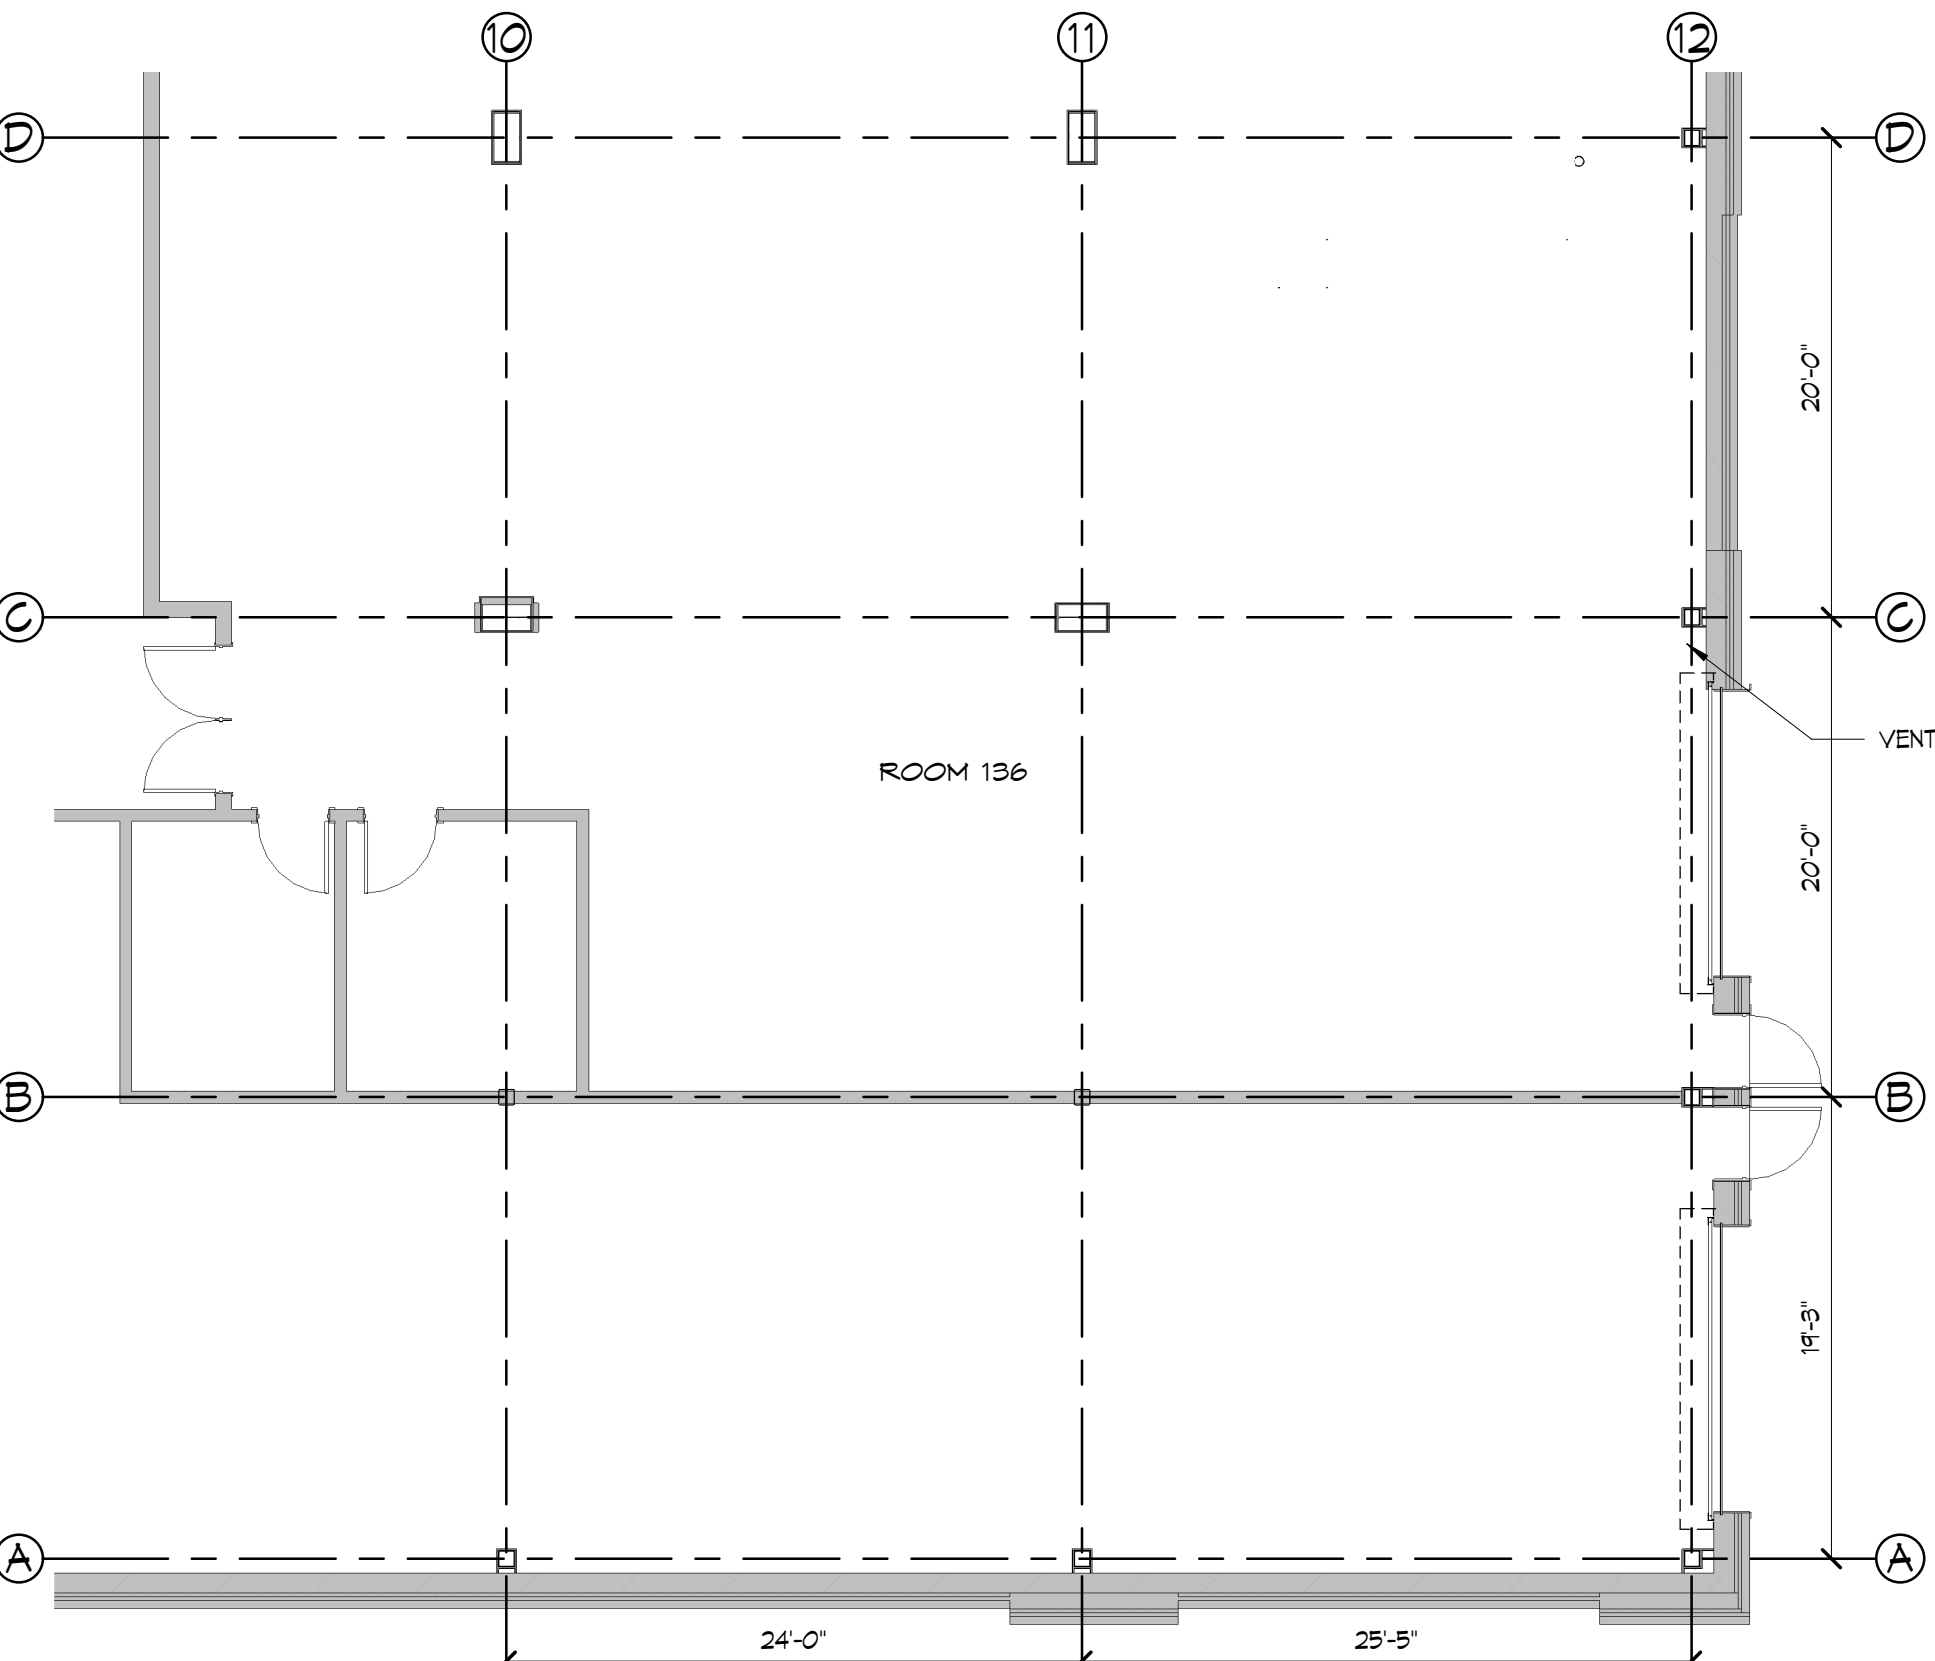

**16 FIRST FLOOR - VENT LOCATION PLAN**  
A2B 1/8" = 1'-0"

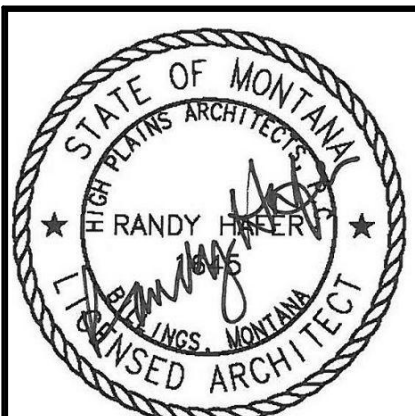


**ROOM 008 BASEMENT REMODEL PLAN**  
**BARNARD ROOM & QUANTUM FOUNDRY RENOVATION**  
**100% CONSTRUCTION DOCUMENTS**

**HIGH PLAINS ARCHITECTS**  
PHONE (409) 896-0250 | FAX (409) 896-0255  
277 G. BOX 2203 | BILLINGS, MT 59103  
WWW.HIGHPLAINSARCHITECTS.COM

DRAWN BY: JIN  
PROJECT#: 22210  
DATE: 04/18/2024

**A2.B**

PLOT STAFF: 4/19/2024 12:50:53 PM

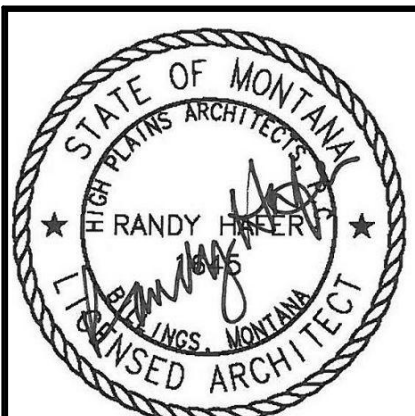

ROOM 008 BASEMENT INTERIOR ELEVATIONS  
BARNARD ROOM & QUANTUM FOUNDRY RENOVATION  
100% CONSTRUCTION DOCUMENTS












HIGH PLAINS ARCHITECTS  
PHONE (406) 896-0250 | FAX (406) 896-0255  
277 G. BOX 2203 | BILLINGS, MT 59103  
WWW.HIGHPLAINSARCHITECTS.COM




DRAWN BY: JIN  
PROJECT#: 22210  
DATE: 04/18/2024


A6.B

PL01 STAFF: 4/19/2024 12:50:40 PM

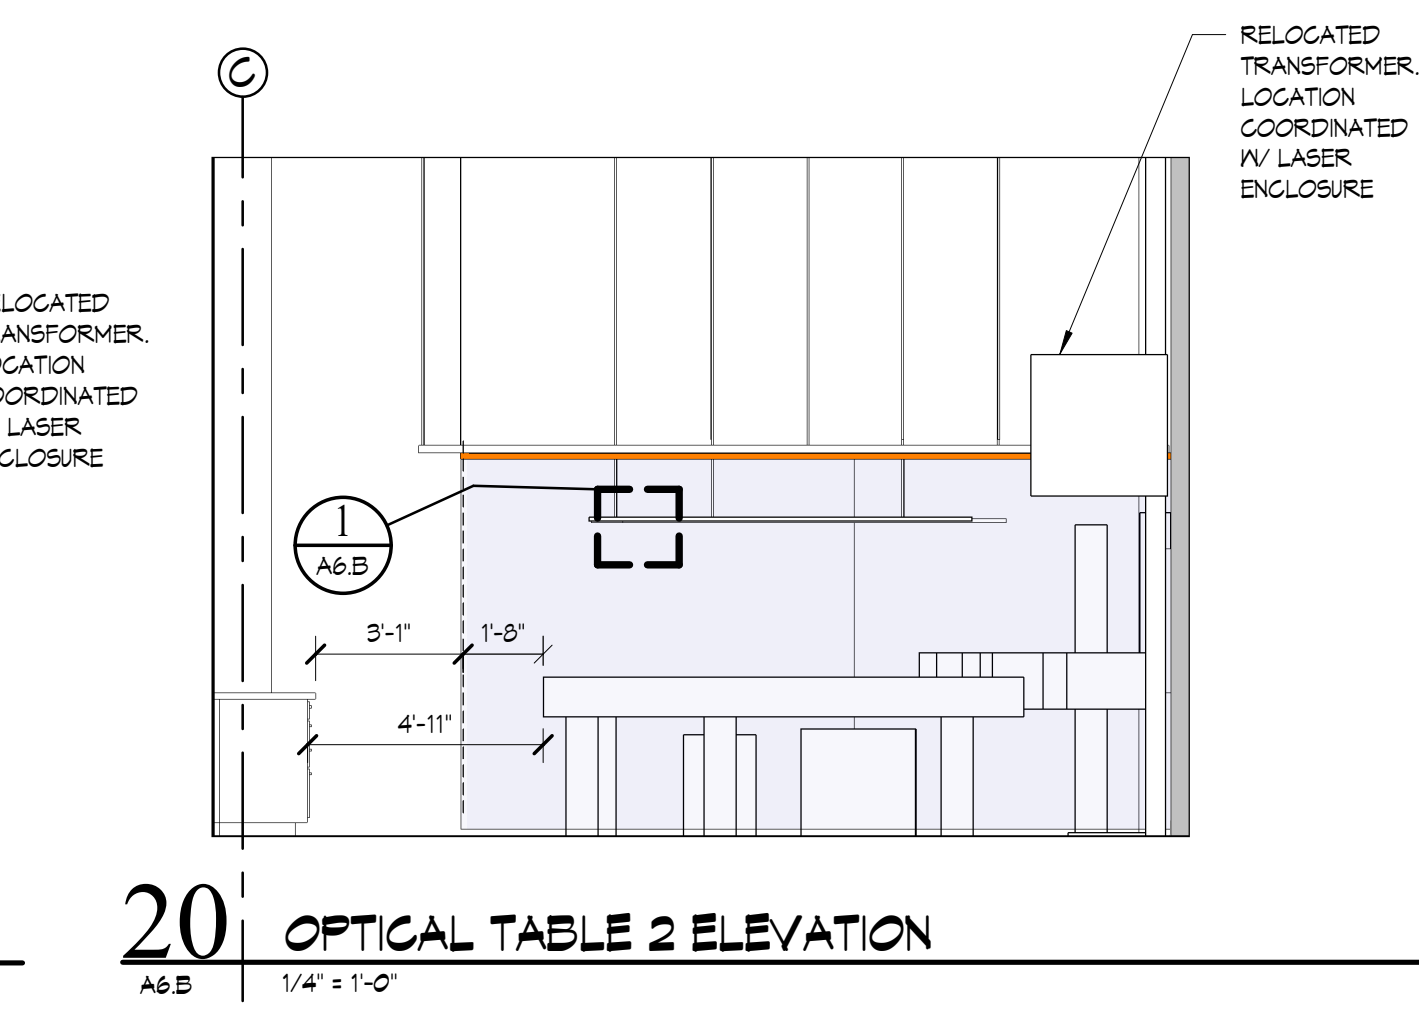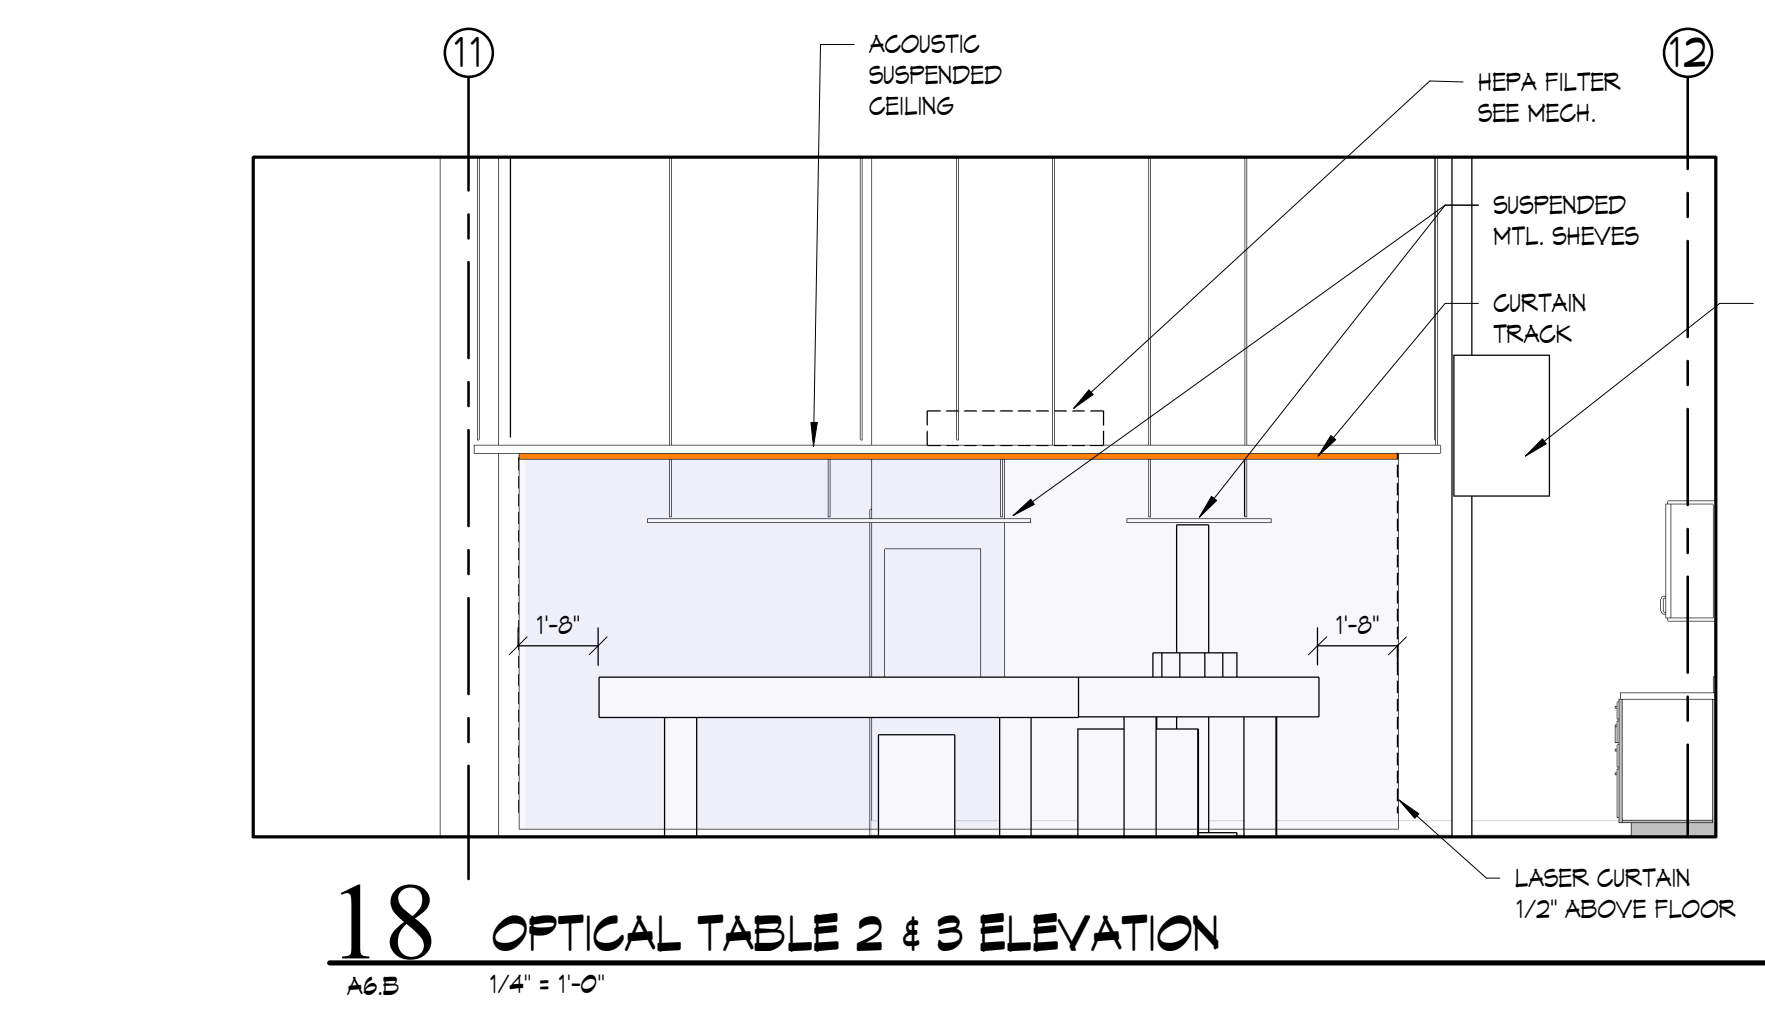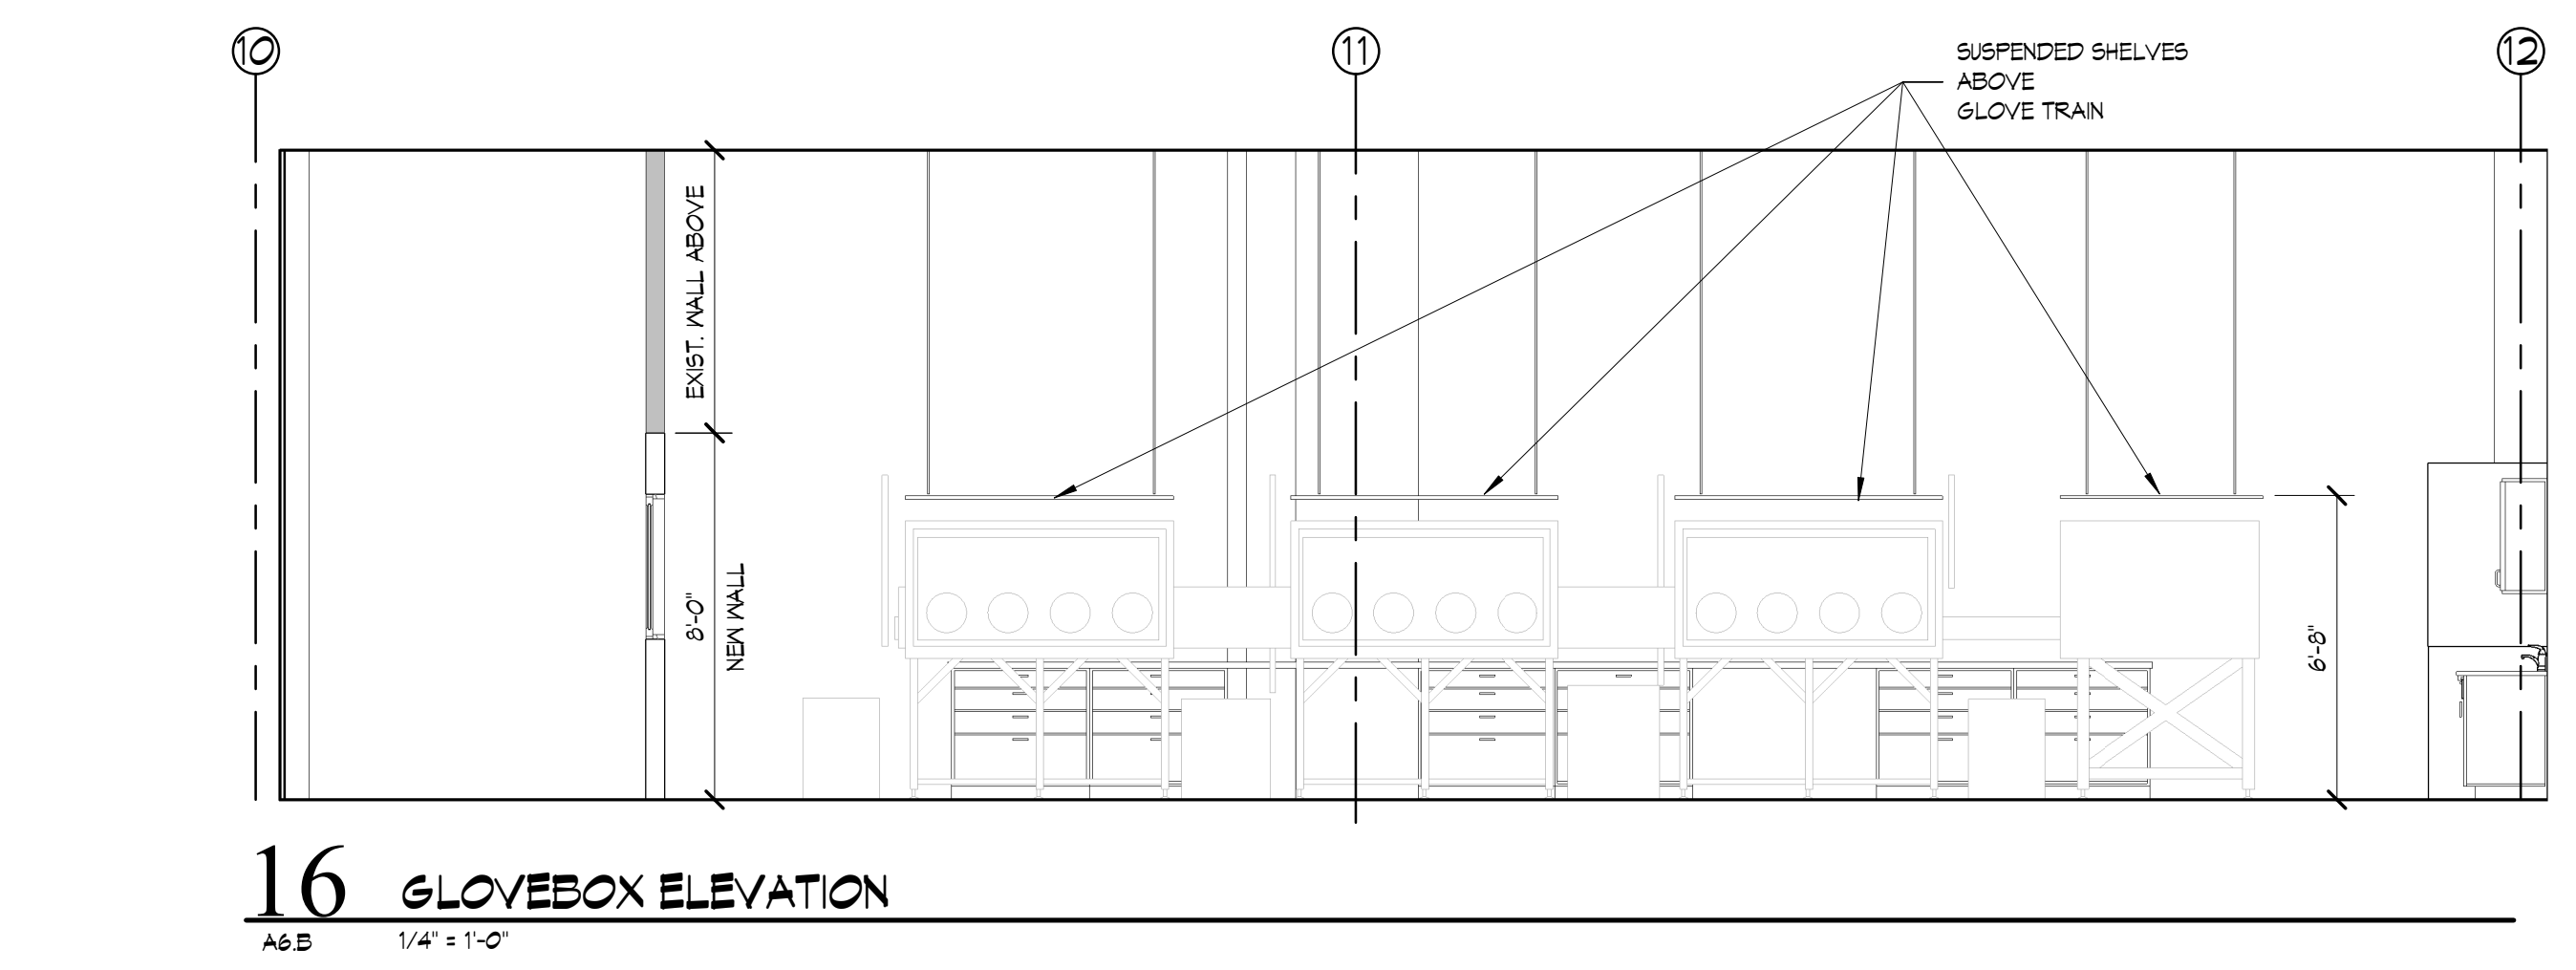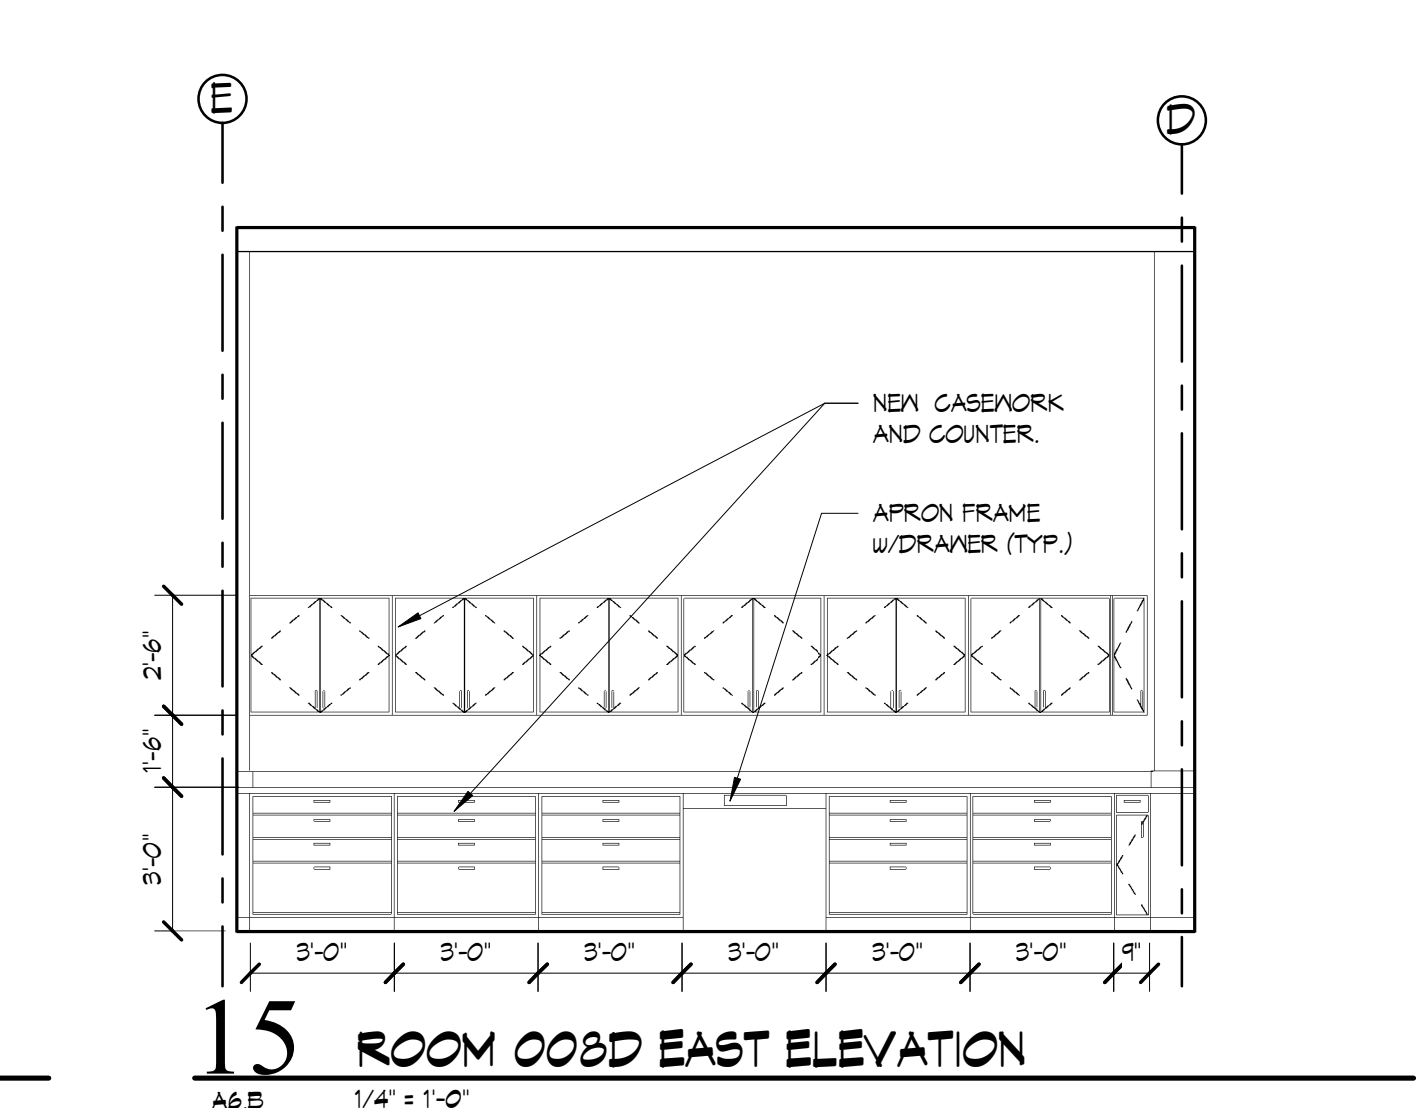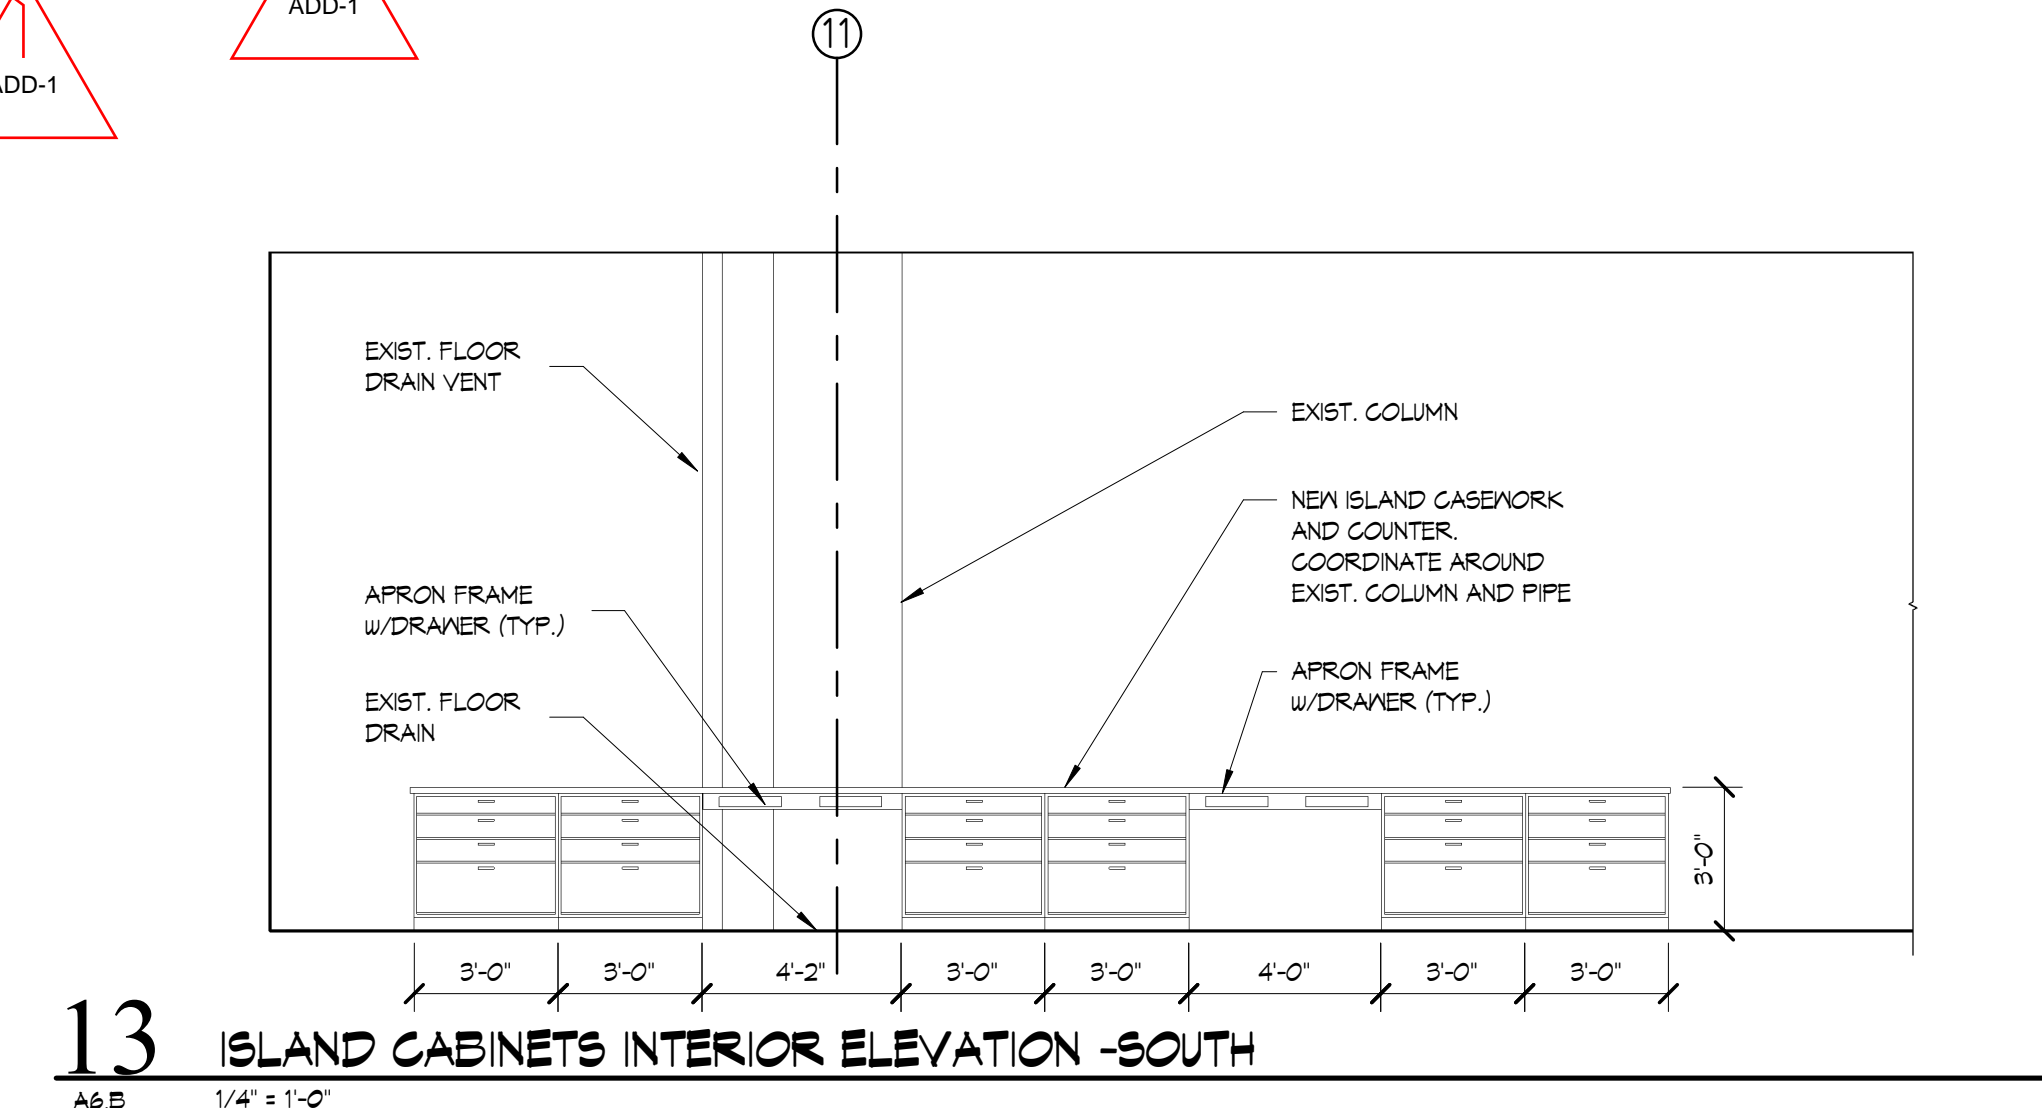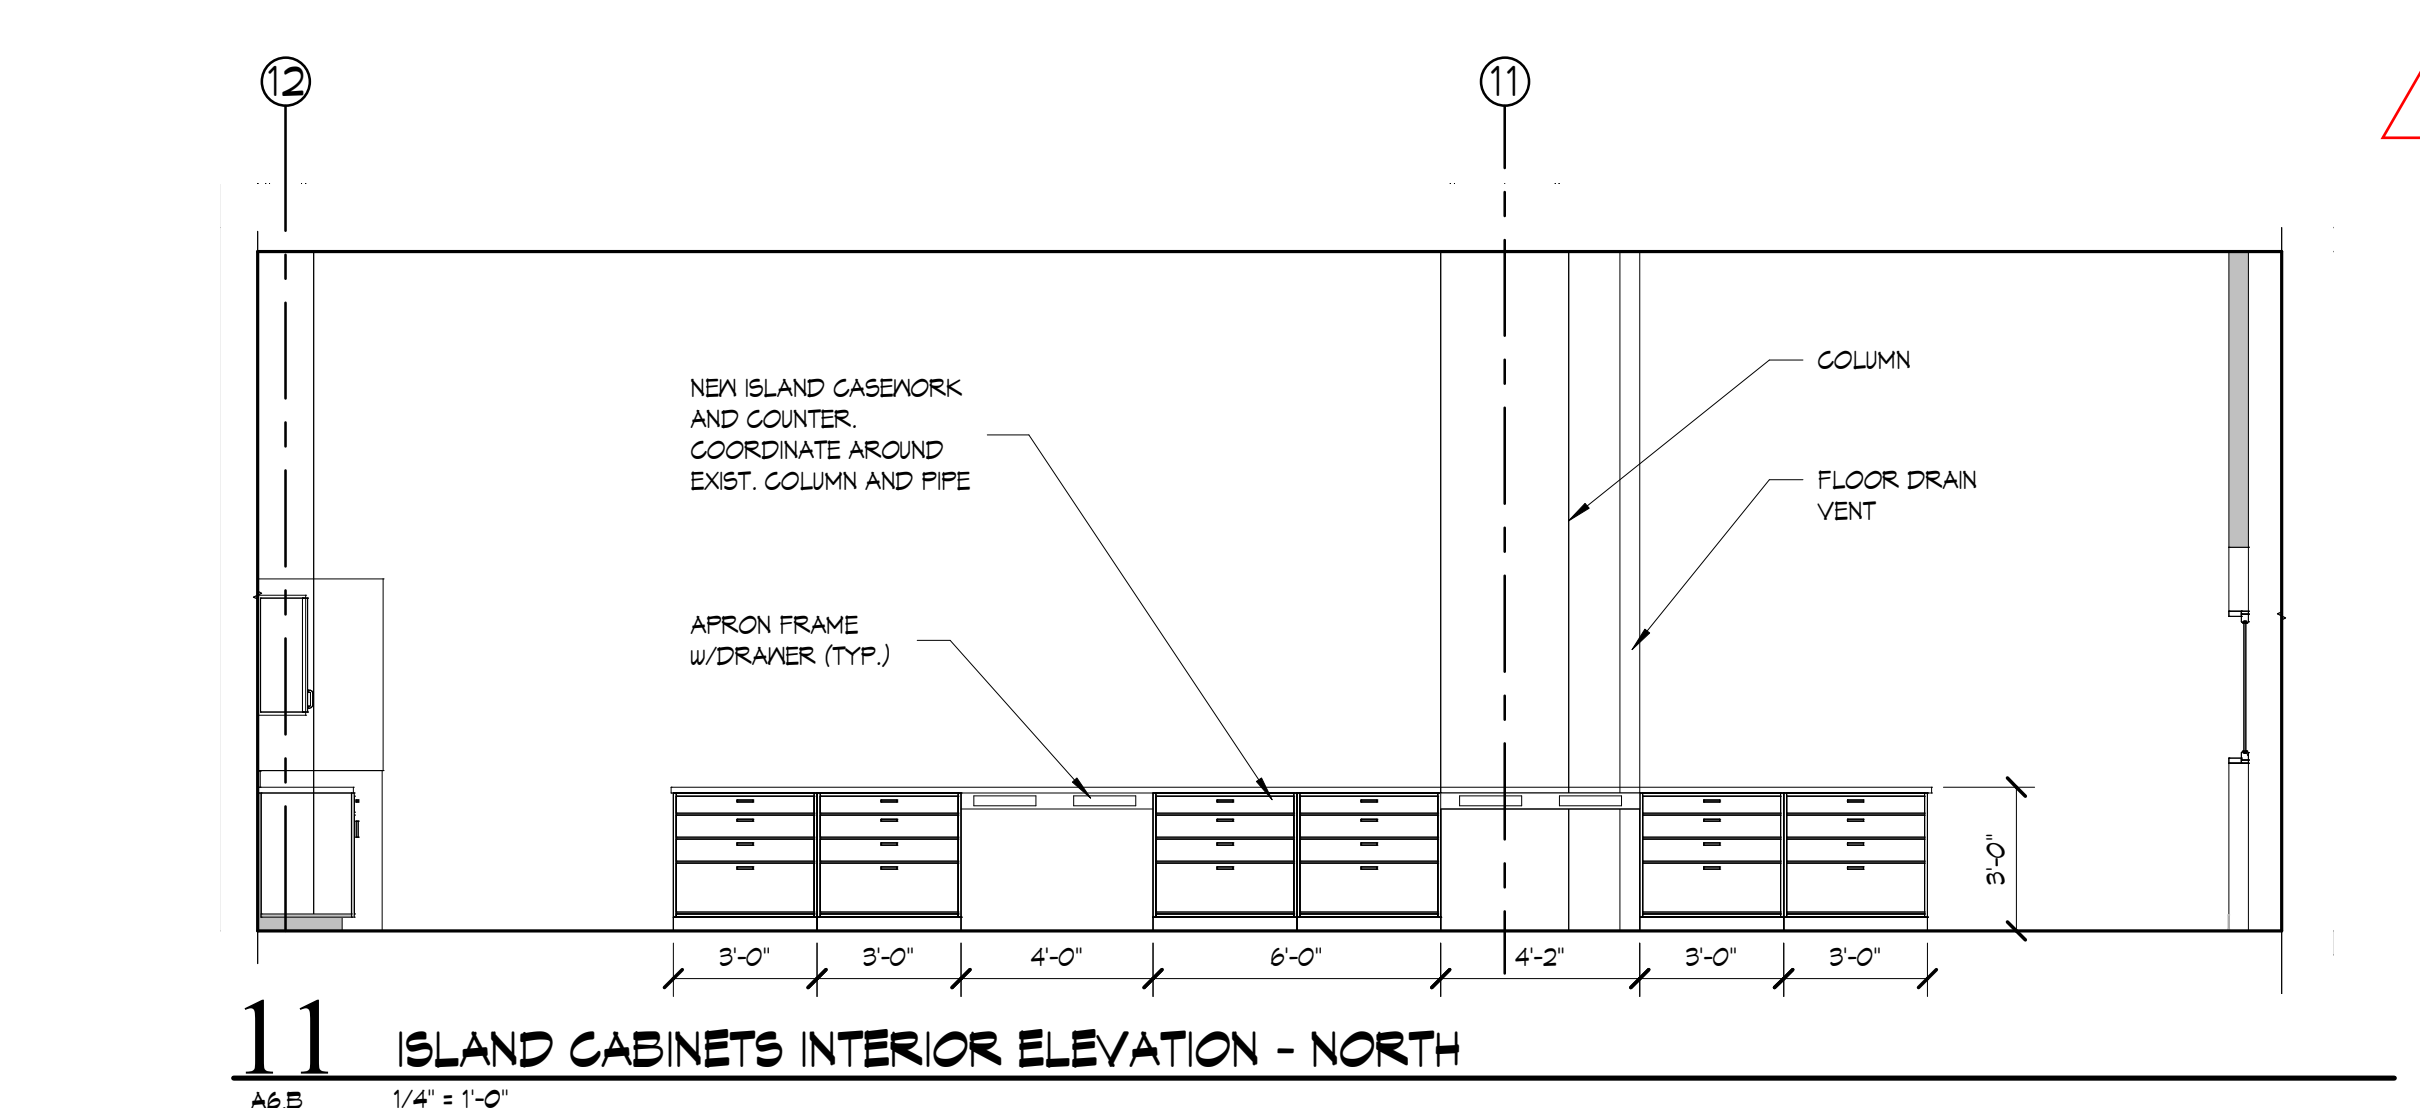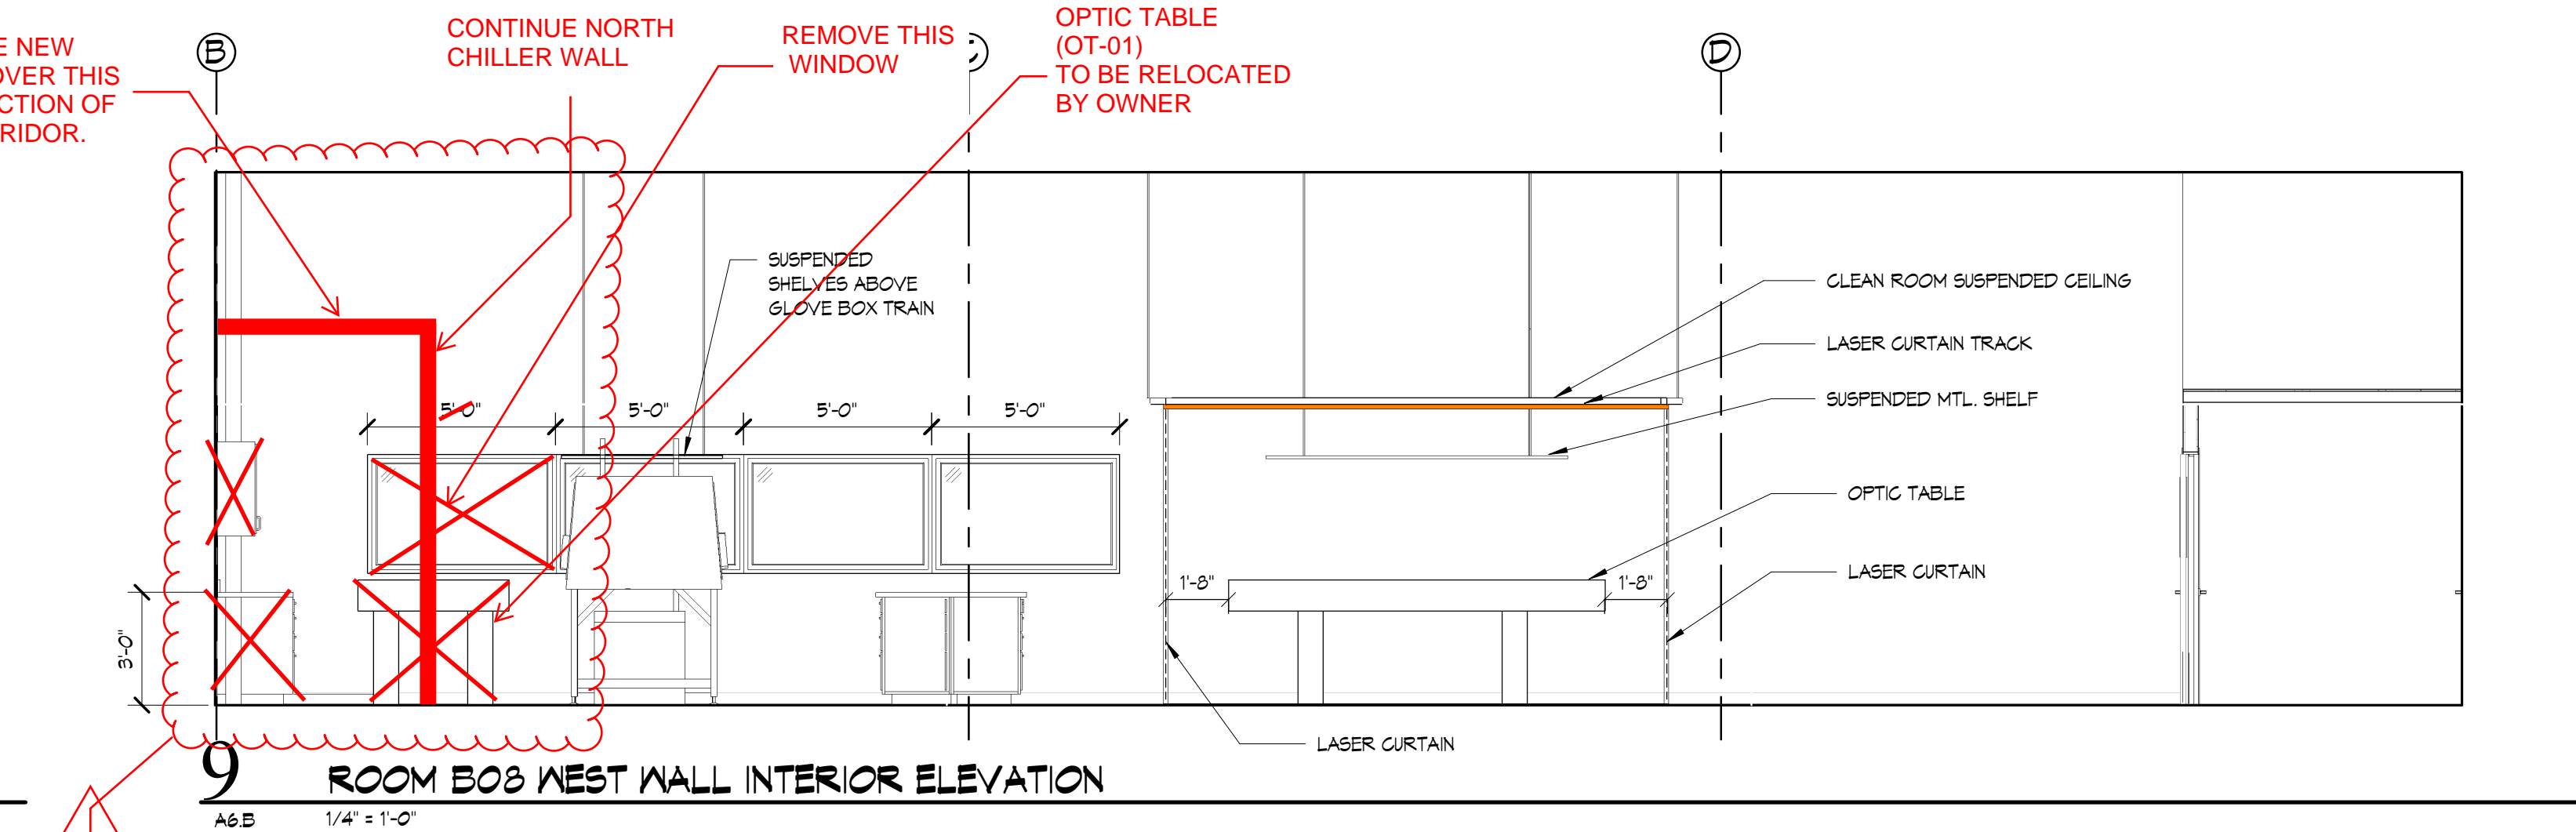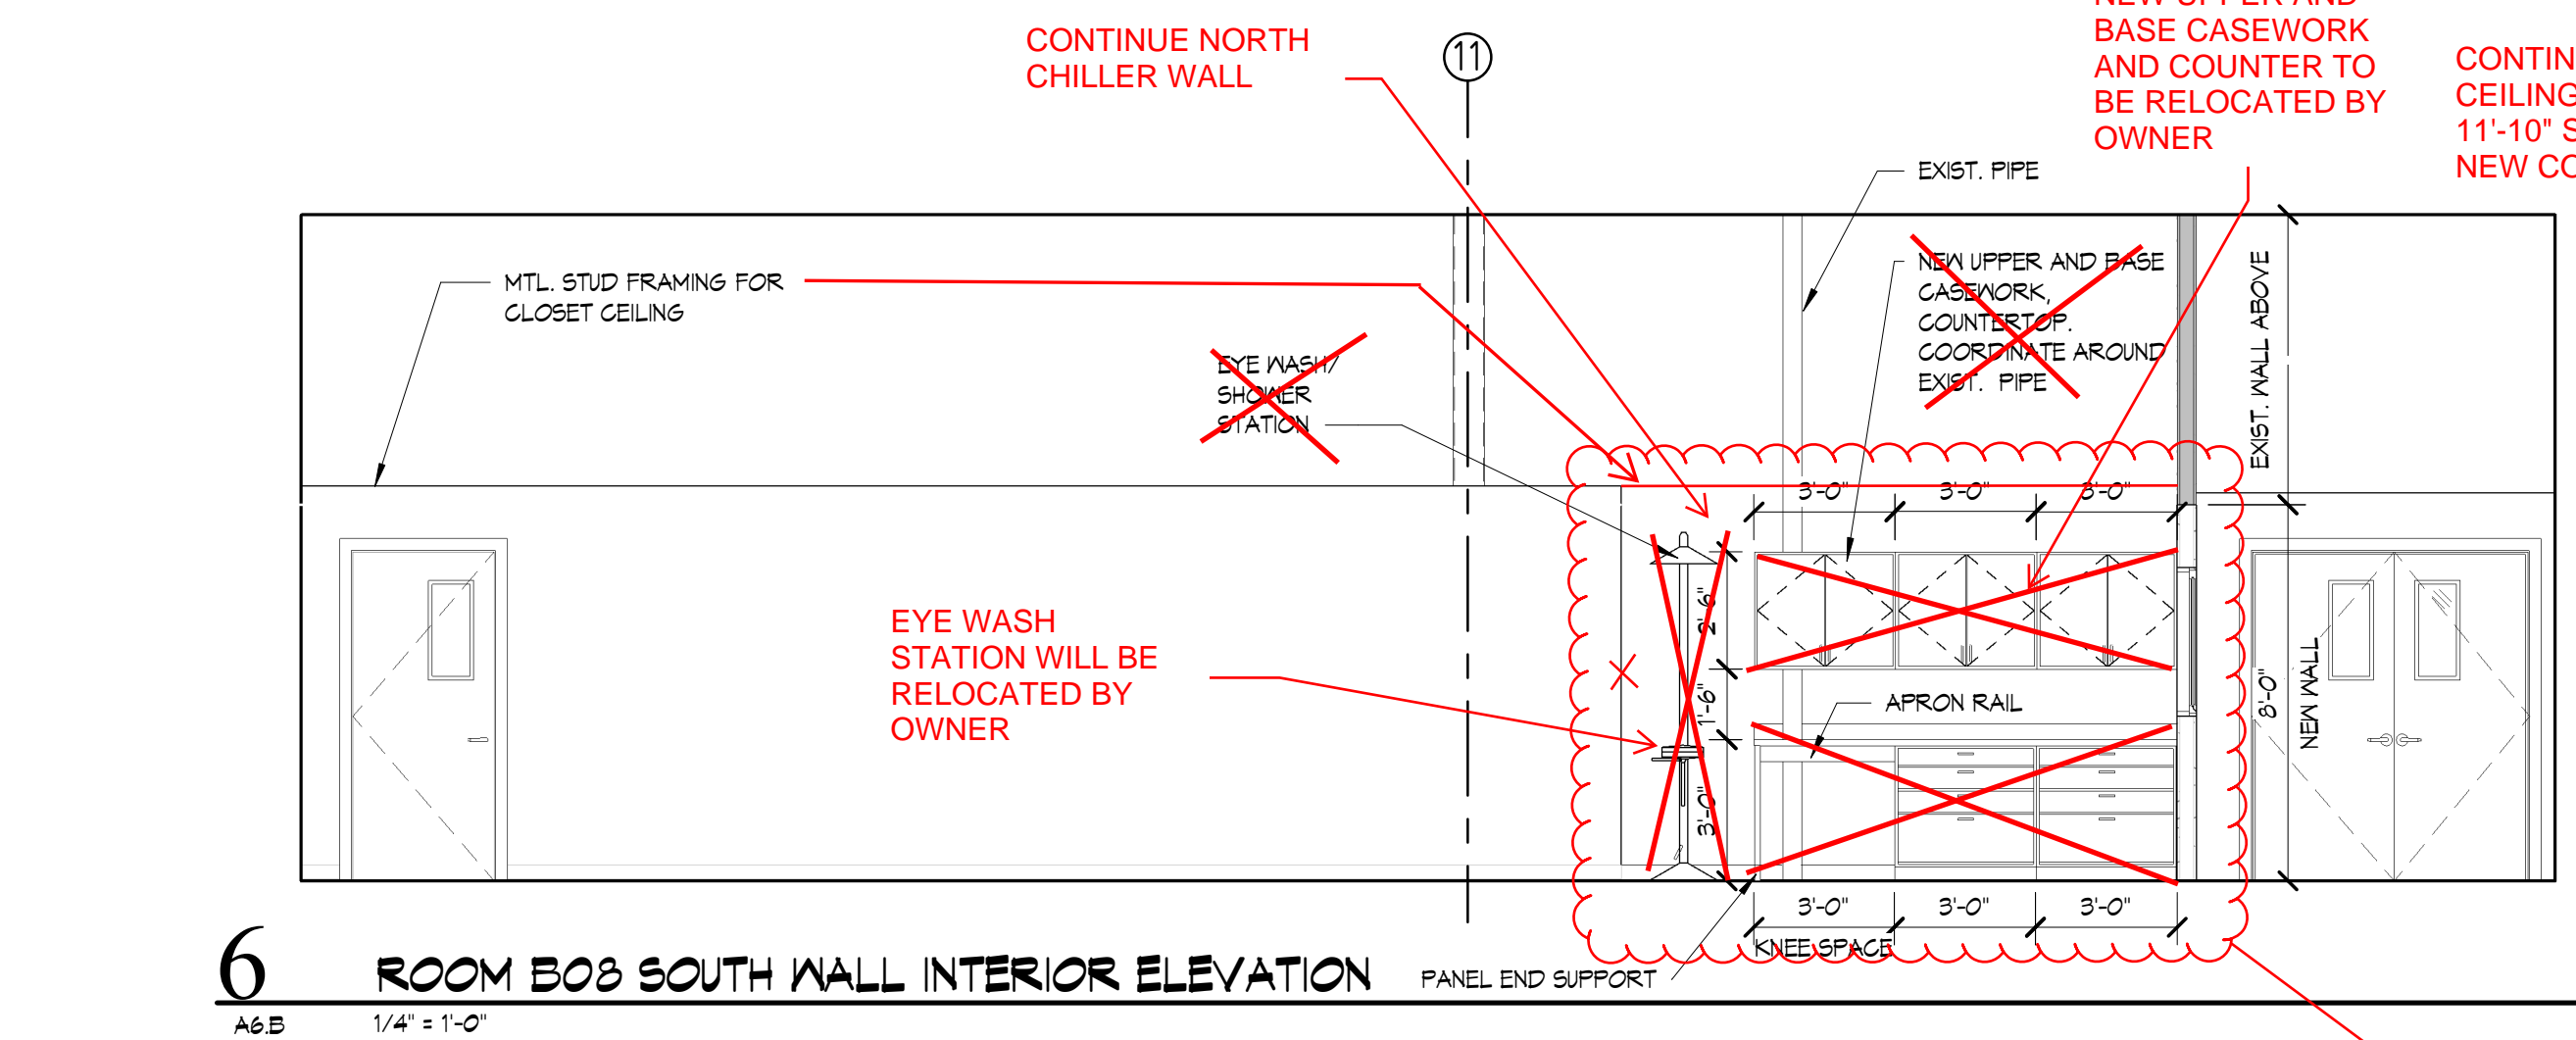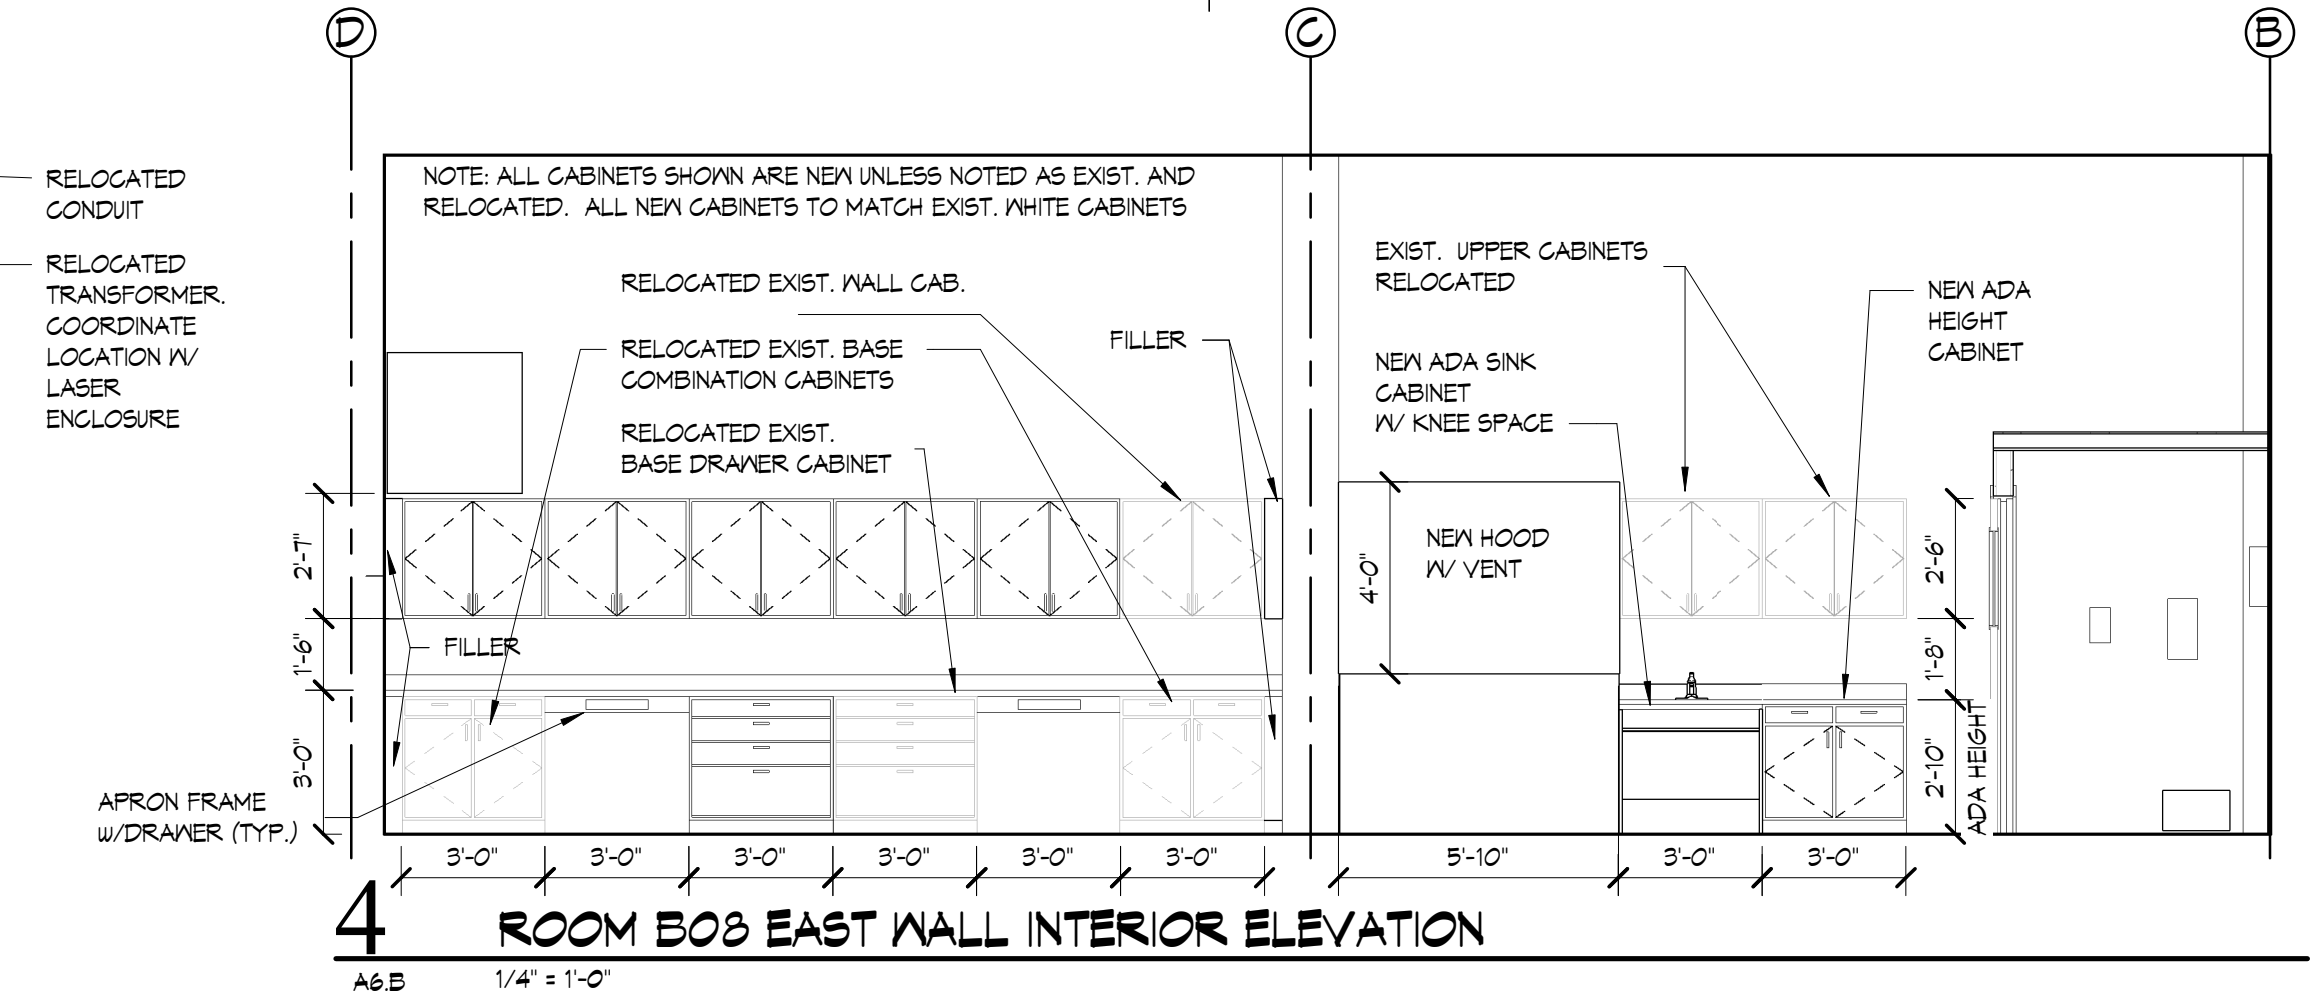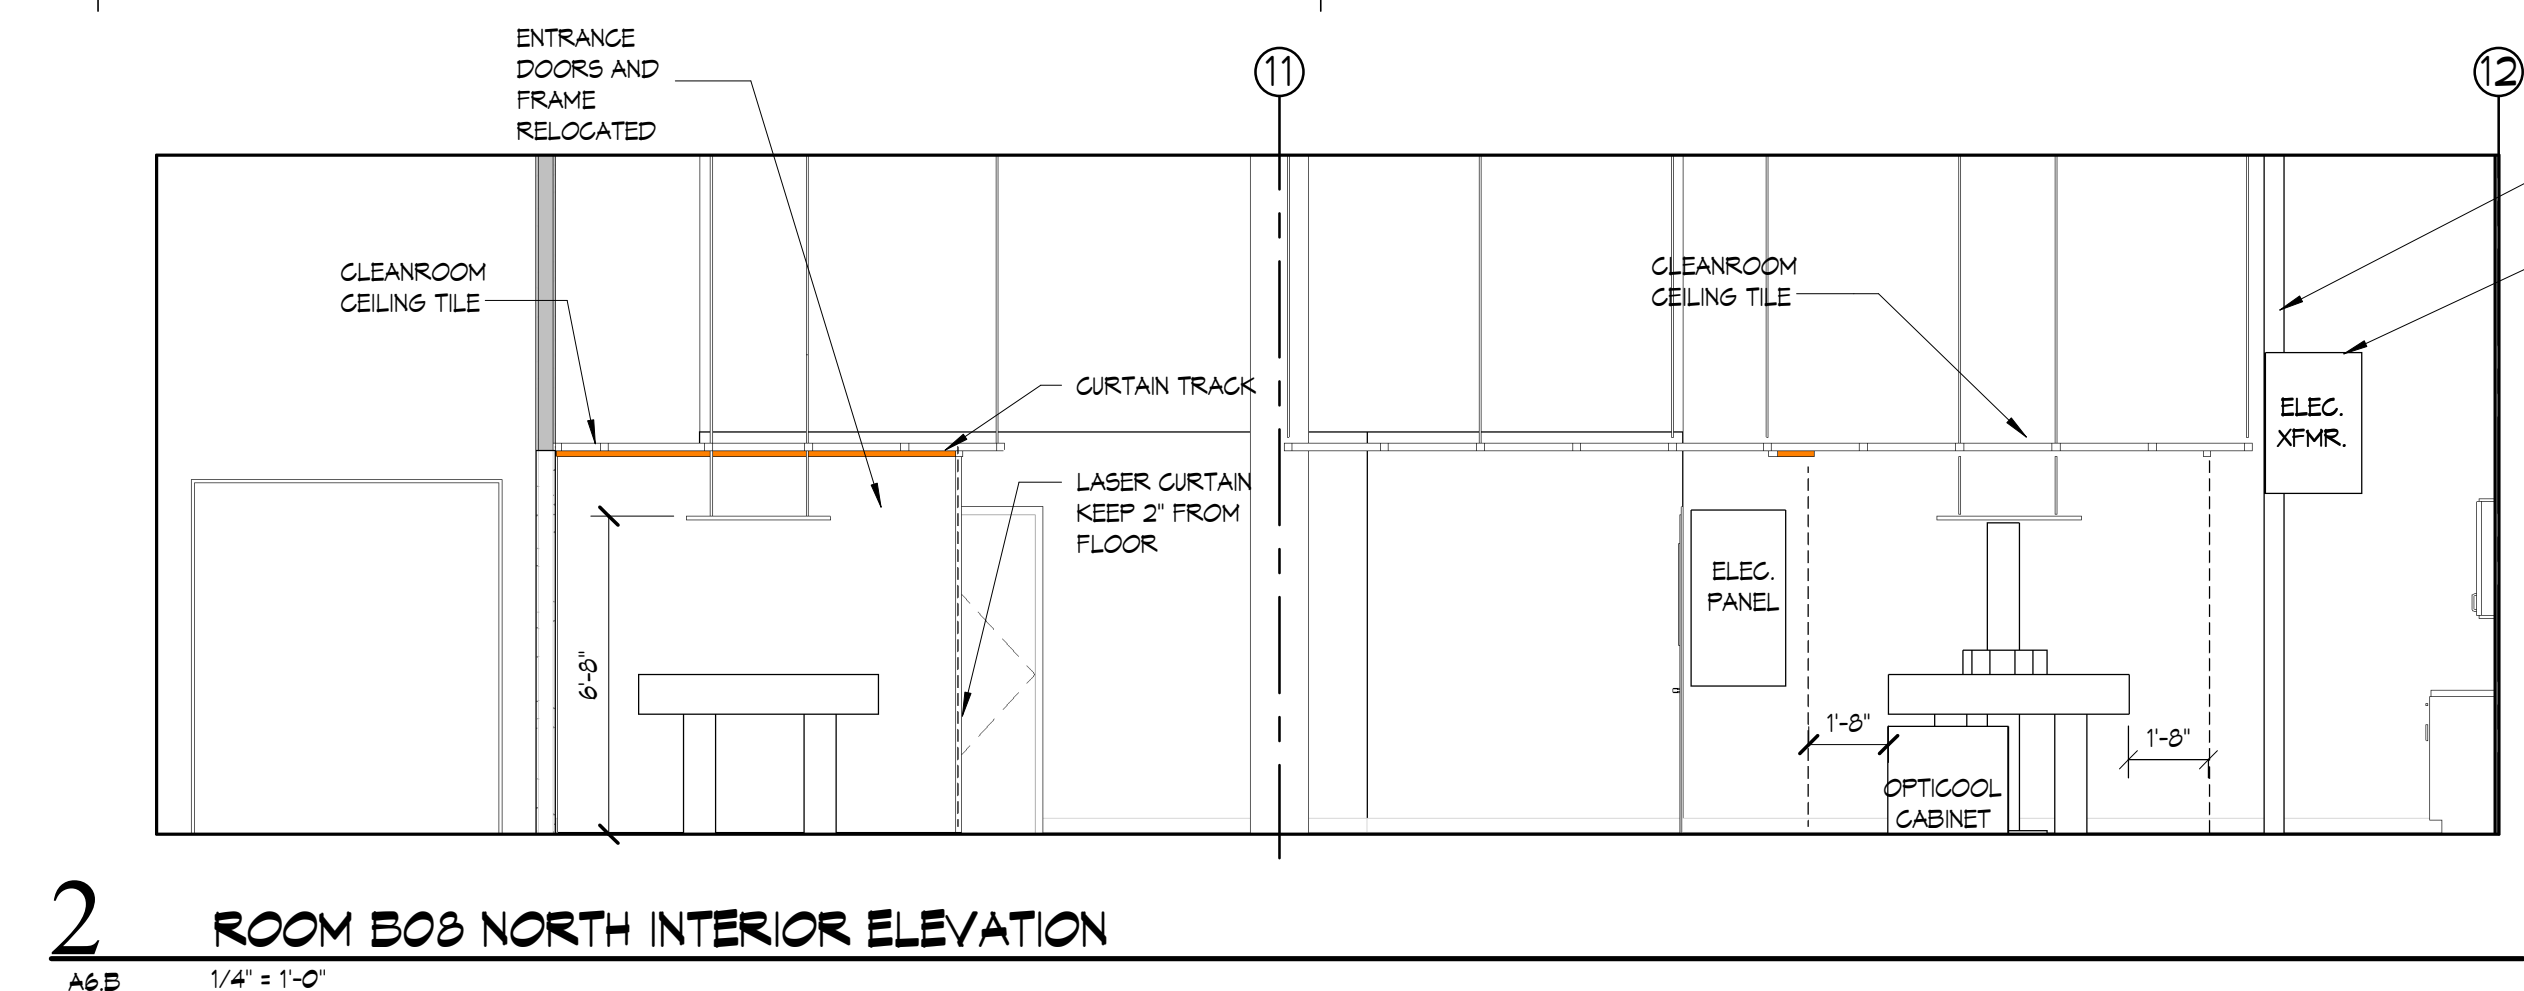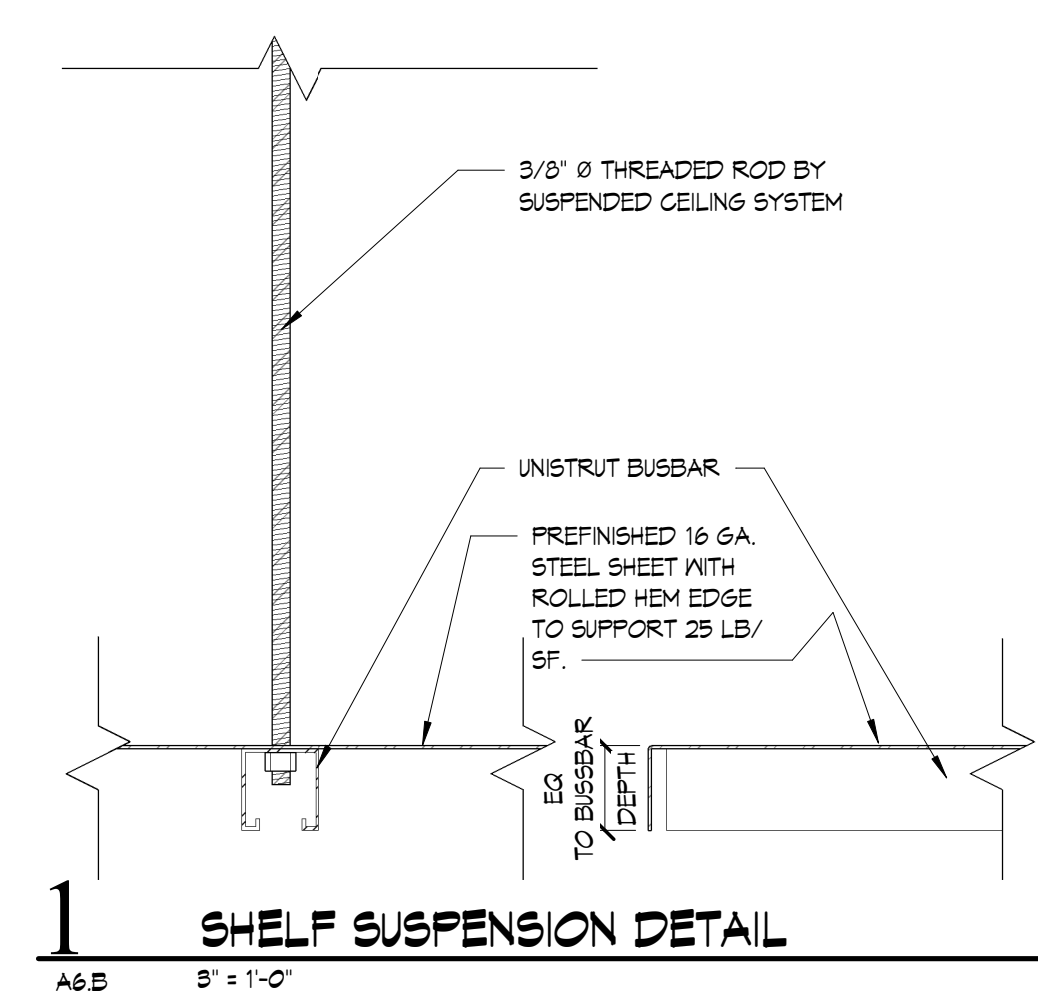


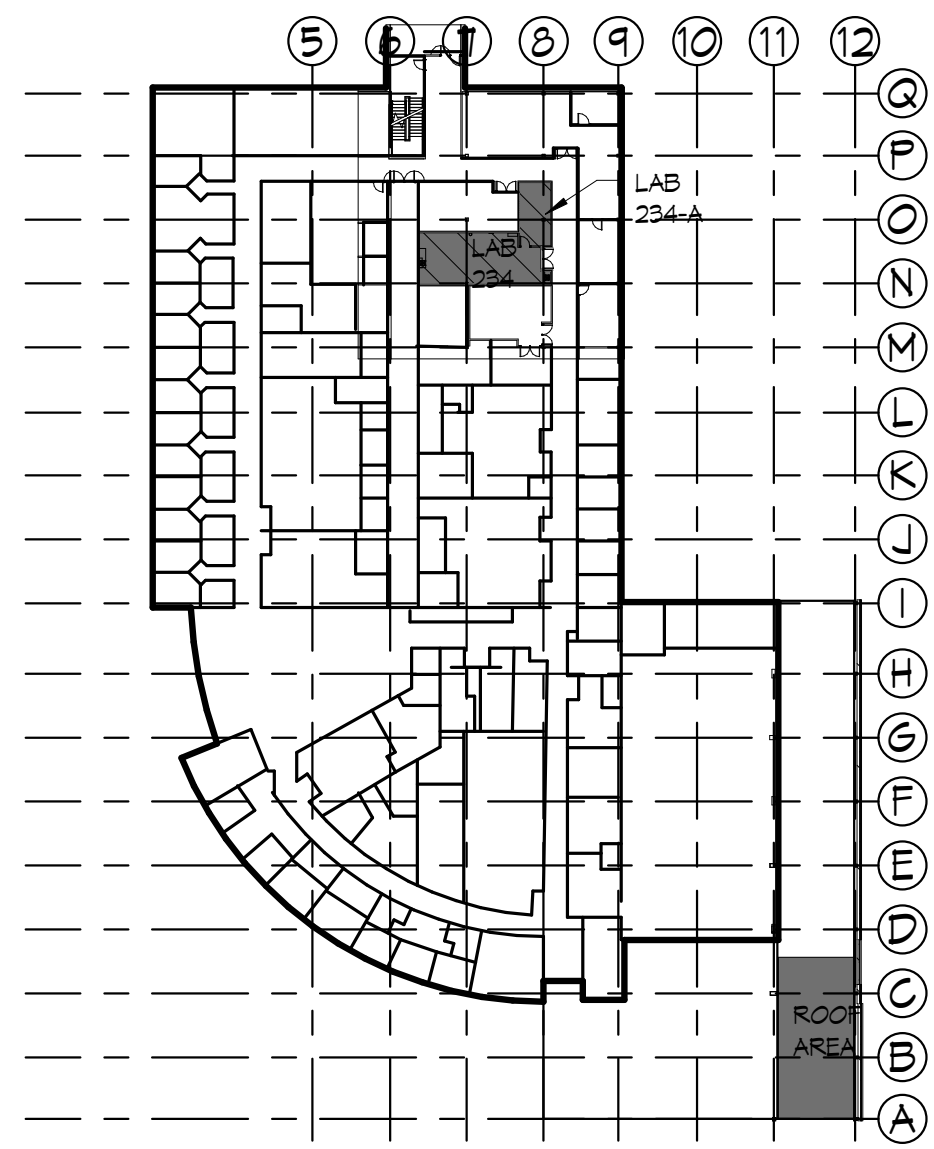

**6 SECOND FLOOR KEY PLAN**  
M2.2 1" = 60'-0"

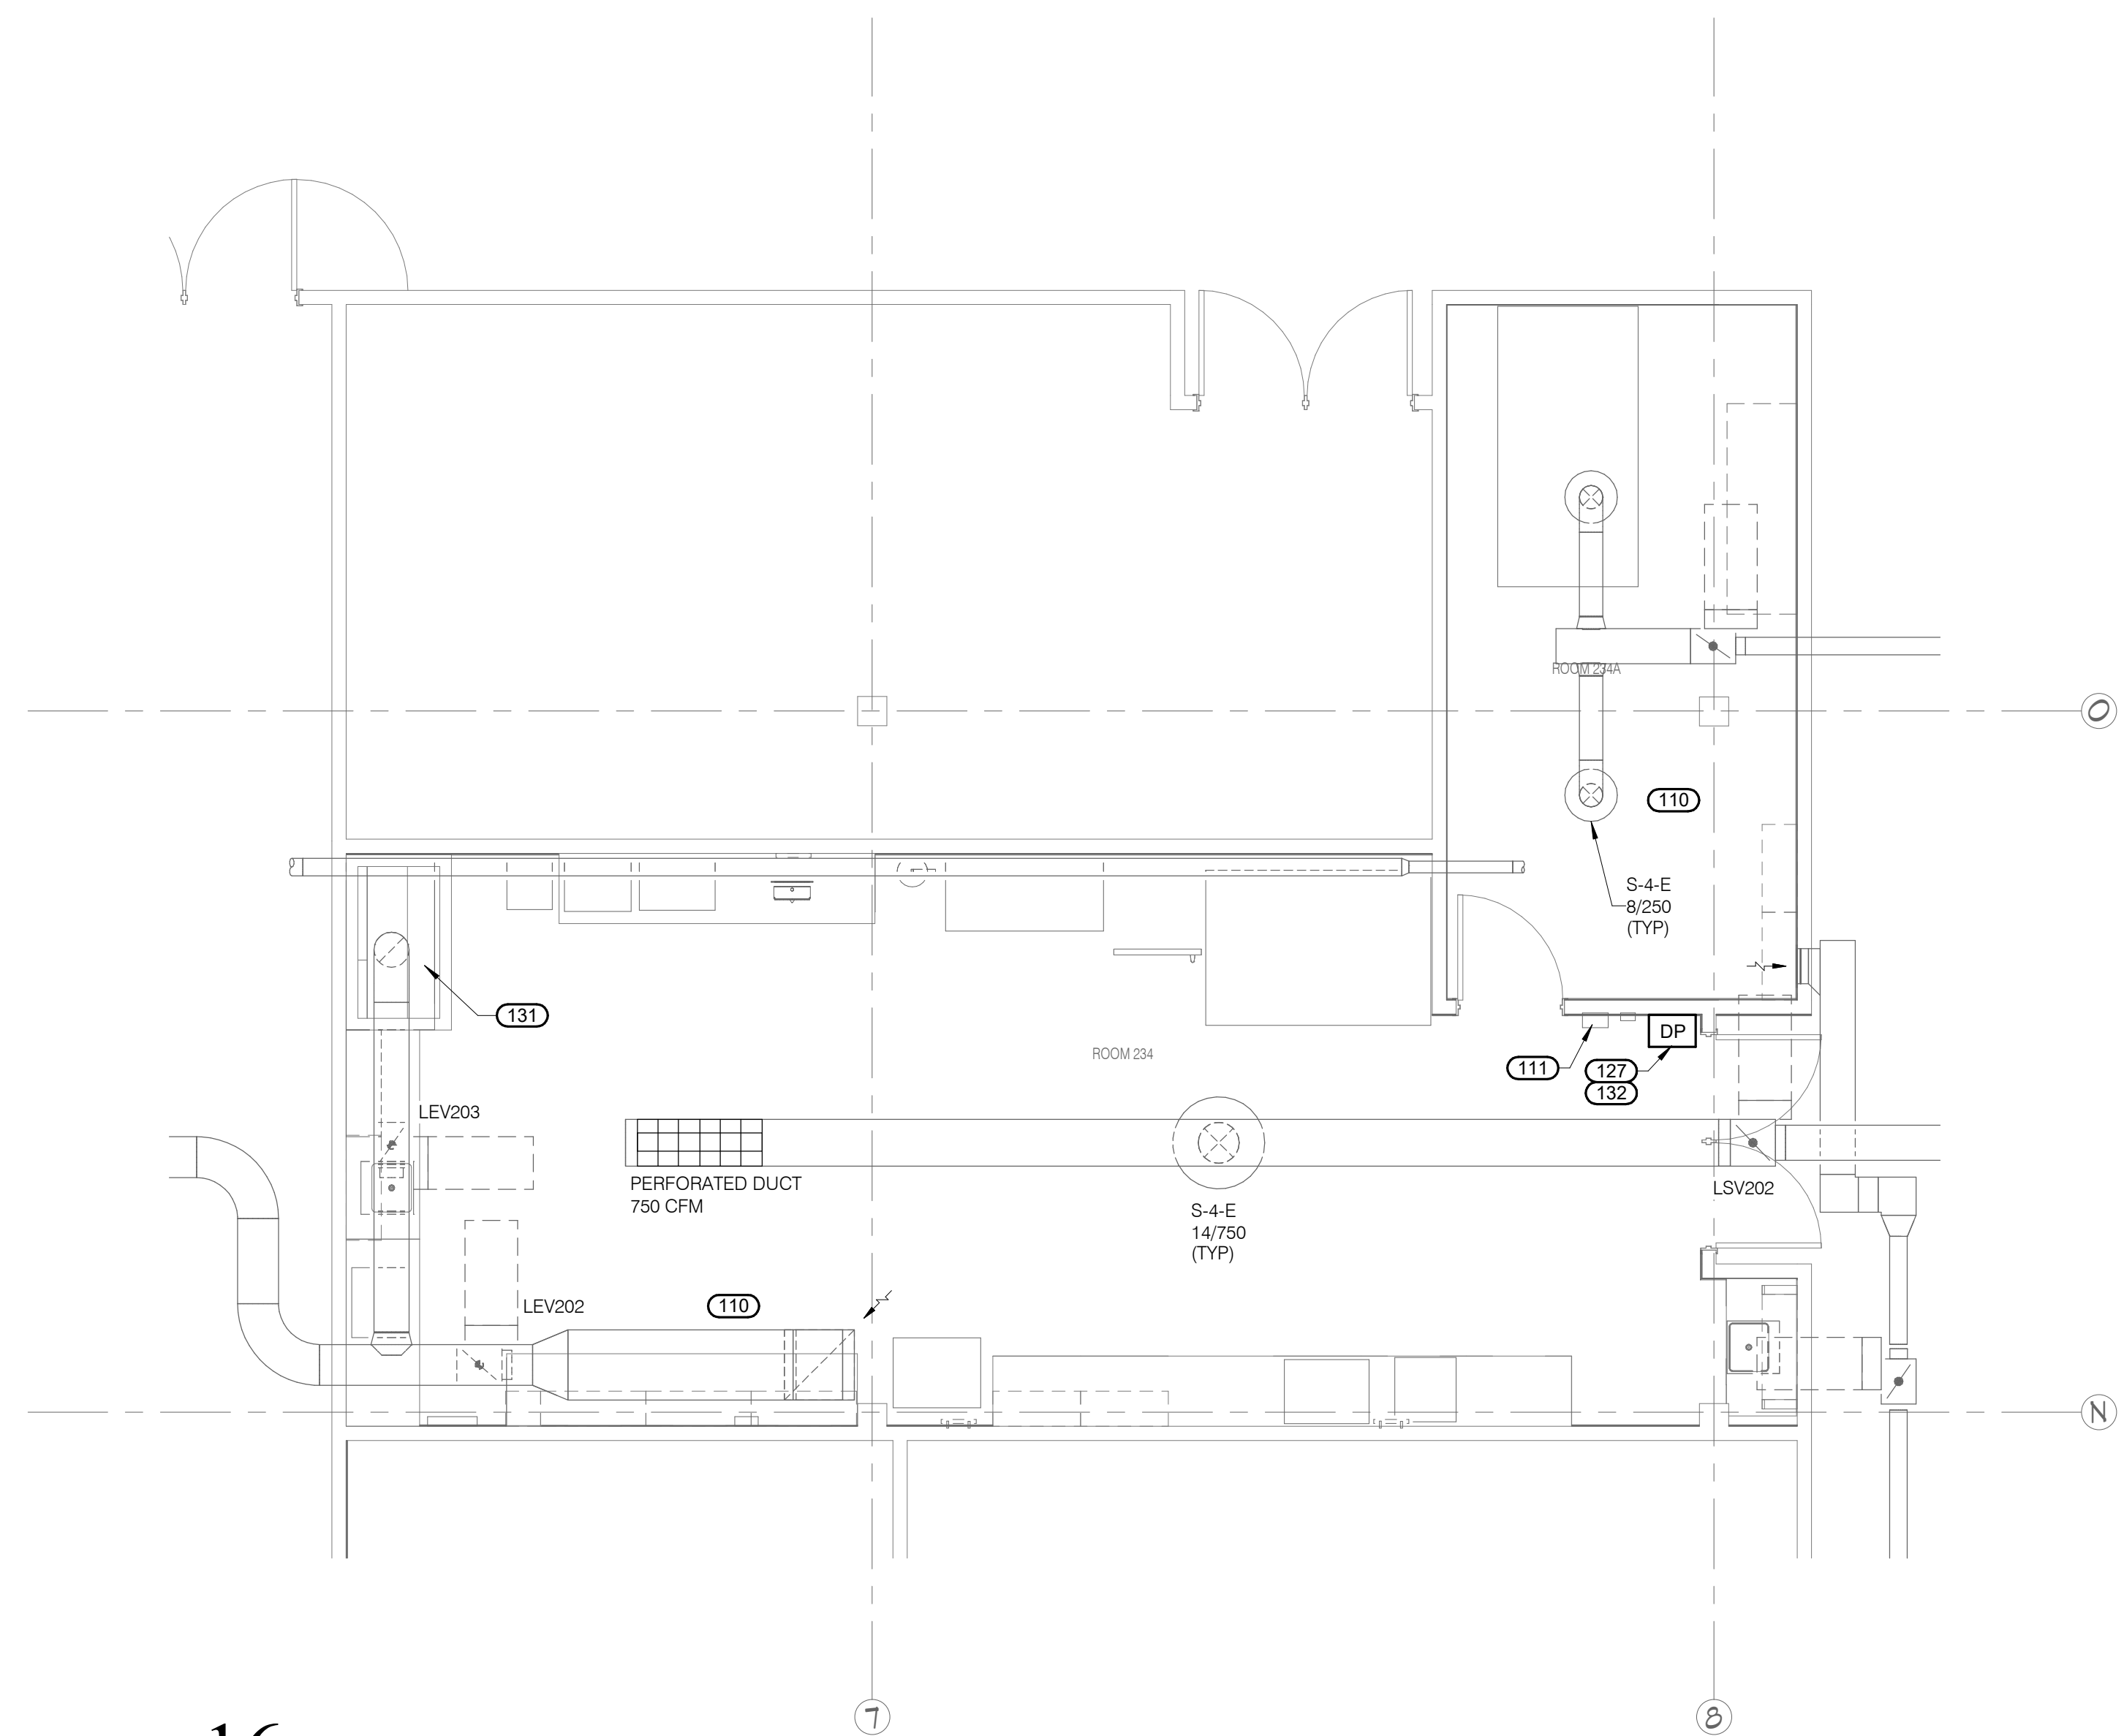

**16 SECOND FLOOR ROOM 234 MECHANICAL PLAN**  
M2.2 1/4" = 1'-0"

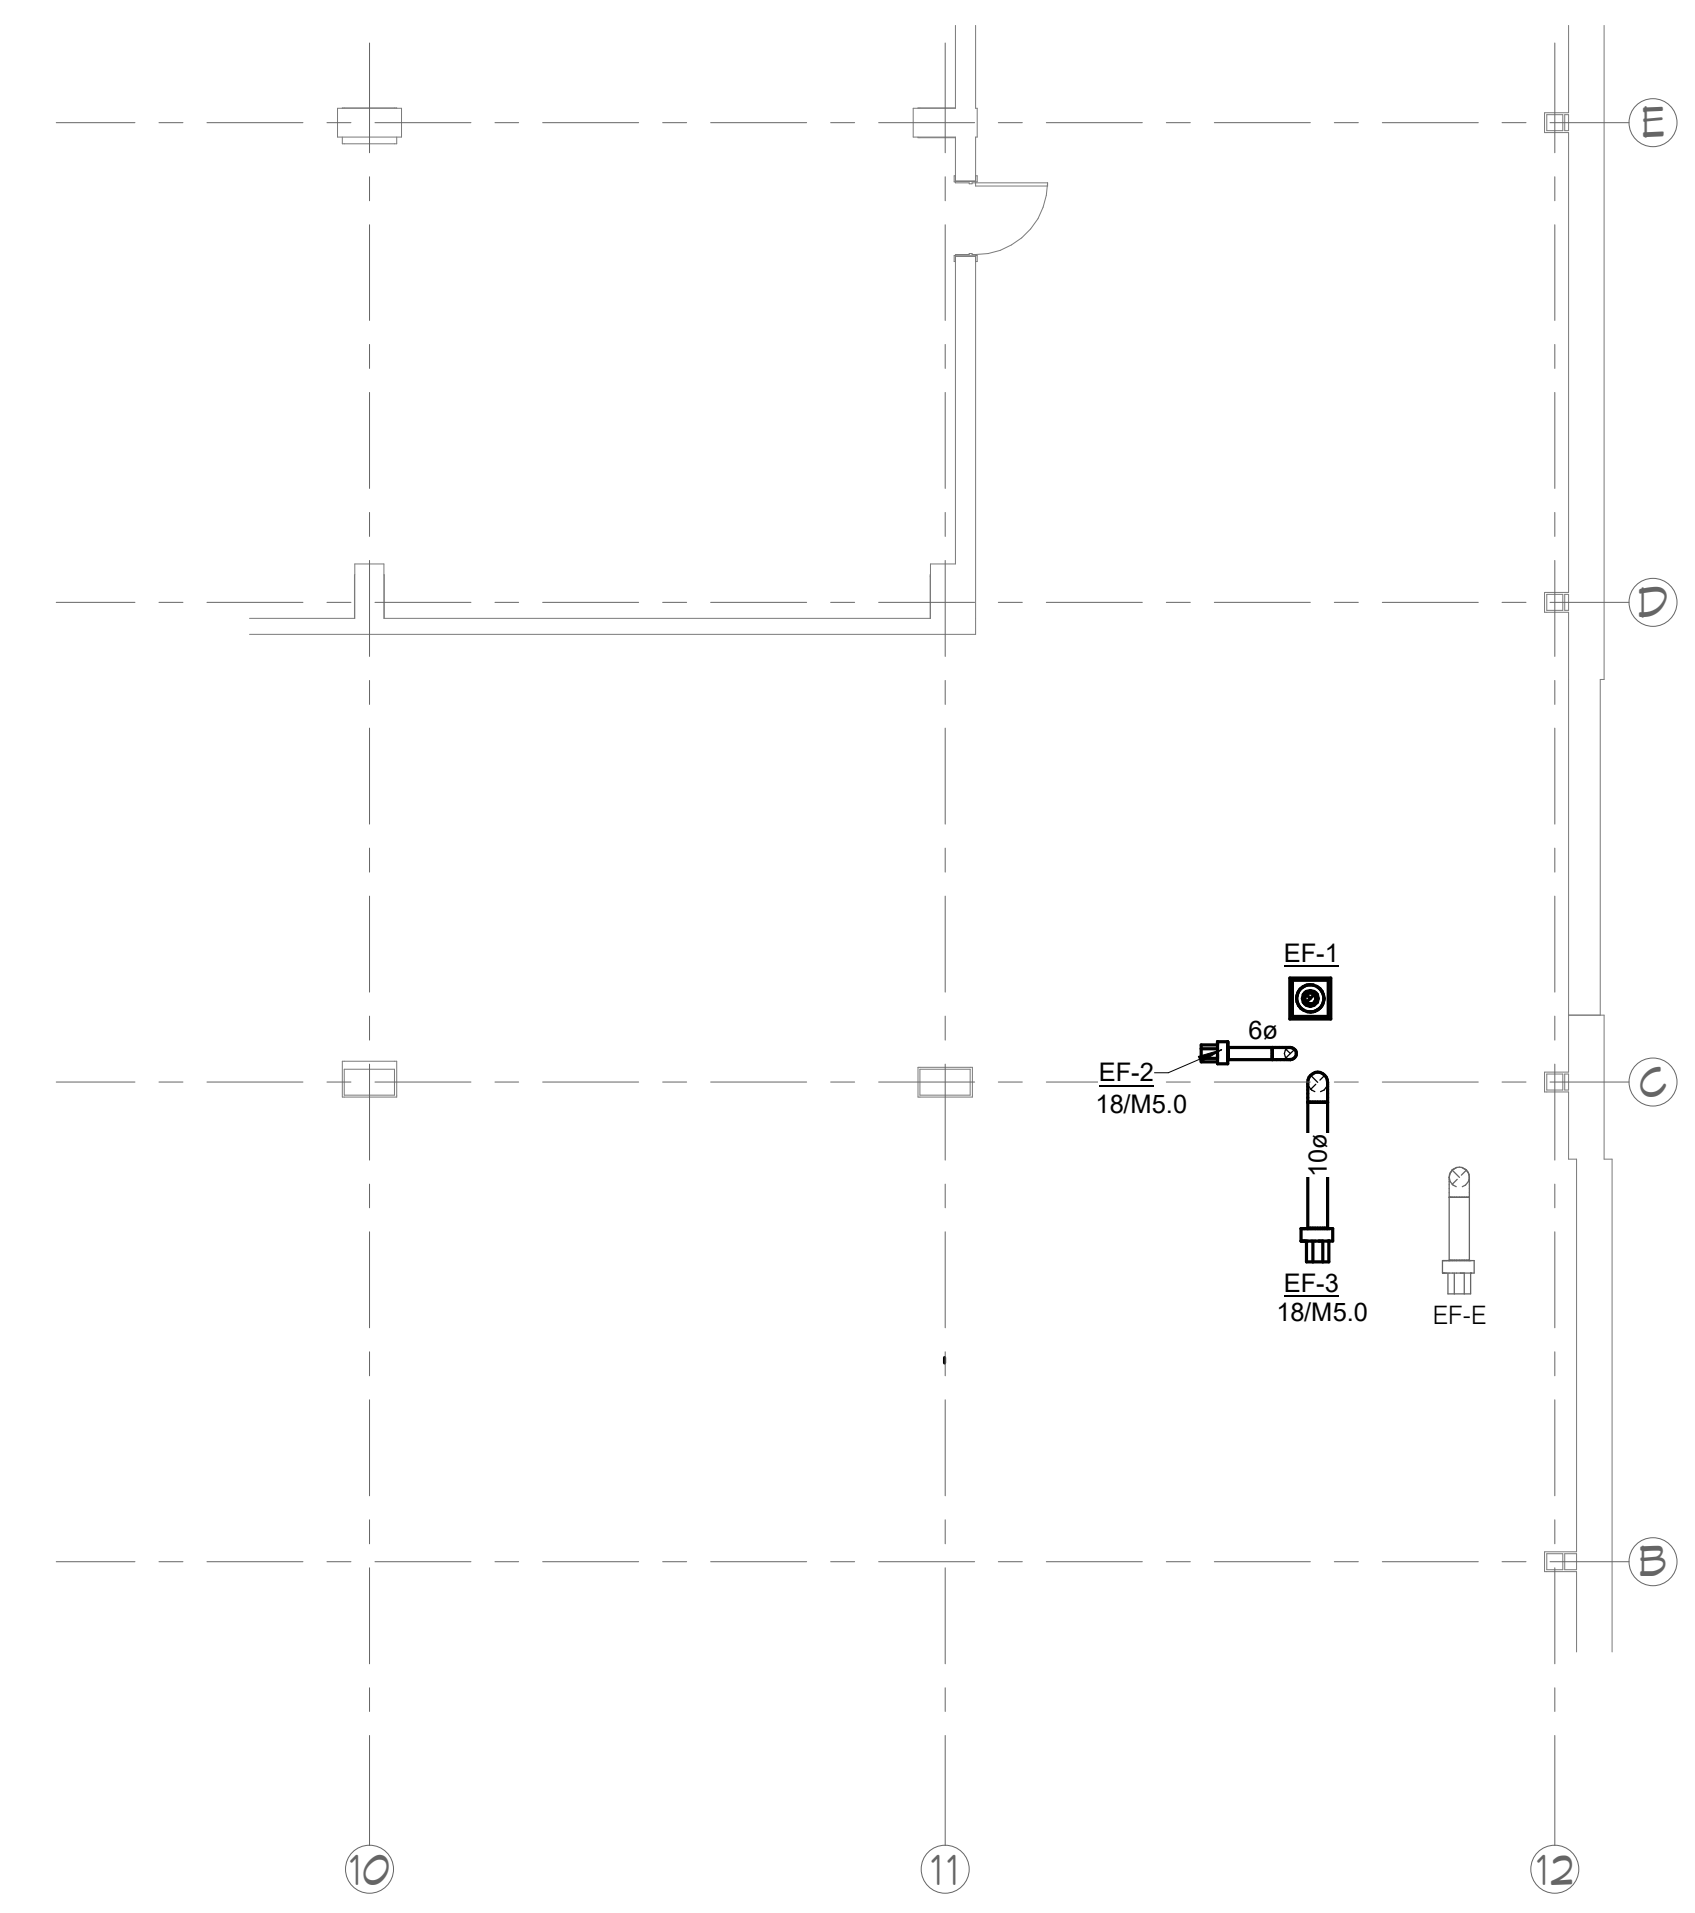


**19 ROOF MECHANICAL PLAN**  
M2.2 1/8" = 1'-0"

ADD-1

**KEYNOTES**

- 110 EXISTING HVAC TO REMAIN AND BE REUSED.
  - ~~111 RELOCATE EXISTING TO PANEL TO THIS LOCATION~~
  - ~~127 PROVIDE WALL MOUNTED DIFFERENTIAL PRESSURE SENSOR~~
  - ~~131 PROVIDE NEW CONTROLLER FOR FUME HOOD EXHAUST AIR VALVE~~
  - ~~SEE FUME HOOD EXHAUST AIR SEQUENCE OF OPERATION~~
  - ~~SEE AIR VALVE CONTROL WHOP WATER HEAT AND ROOM~~
  - ~~REQUIRE CONTROL SEQUENCE OF OPERATION~~
- NOTE: EXISTING CONTROLS SERVING THE SPACE WILL REMAIN AND BE REUSED.

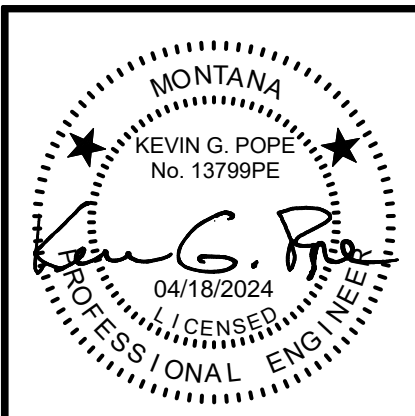

**IMEG**  
1515 27TH STREET  
BILLINGS, MT 59001  
P: 406.256.1141  
WWW.PROJECT360.COM

IMEG CORP. RESERVES PROPRIETARY RIGHTS, INCLUDING COPYRIGHTS, IN ALL INFORMATION AND DATA. THE EXCLUSIVE PROPERTY OF IMEG CORP. AND ANY OTHER INFORMATION CONTAINED HEREIN IS UNCLASSIFIED AND NOT FOR DISTRIBUTION OUTSIDE OF THE PROJECT. ©2022 IMEG CORP. PROJECT #2208970.00  
REF. SCALE IN INCHES


**SECOND FLOOR ROOM 234 MECHANICAL PLAN**  
**BARNARD ROOM 8 QUANTUM FOUNDRY RENOVATION**  
**100% CONSTRUCTION DOCUMENTS**

**HIGH PLAINS ARCHITECTS**  
PHONE (406) 866-0250 | FAX (406) 866-0255  
277 G. BOX 2203 | BILLINGS, MT 59103  
WWW.HIGHPLAINSARCHITECTS.COM

DRAWN BY: KWH  
PROJECT#: 22210  
DATE: 04/18/2024

**M2.2**

PLOT STAMP: 4/18/2024 9:40:01 AM

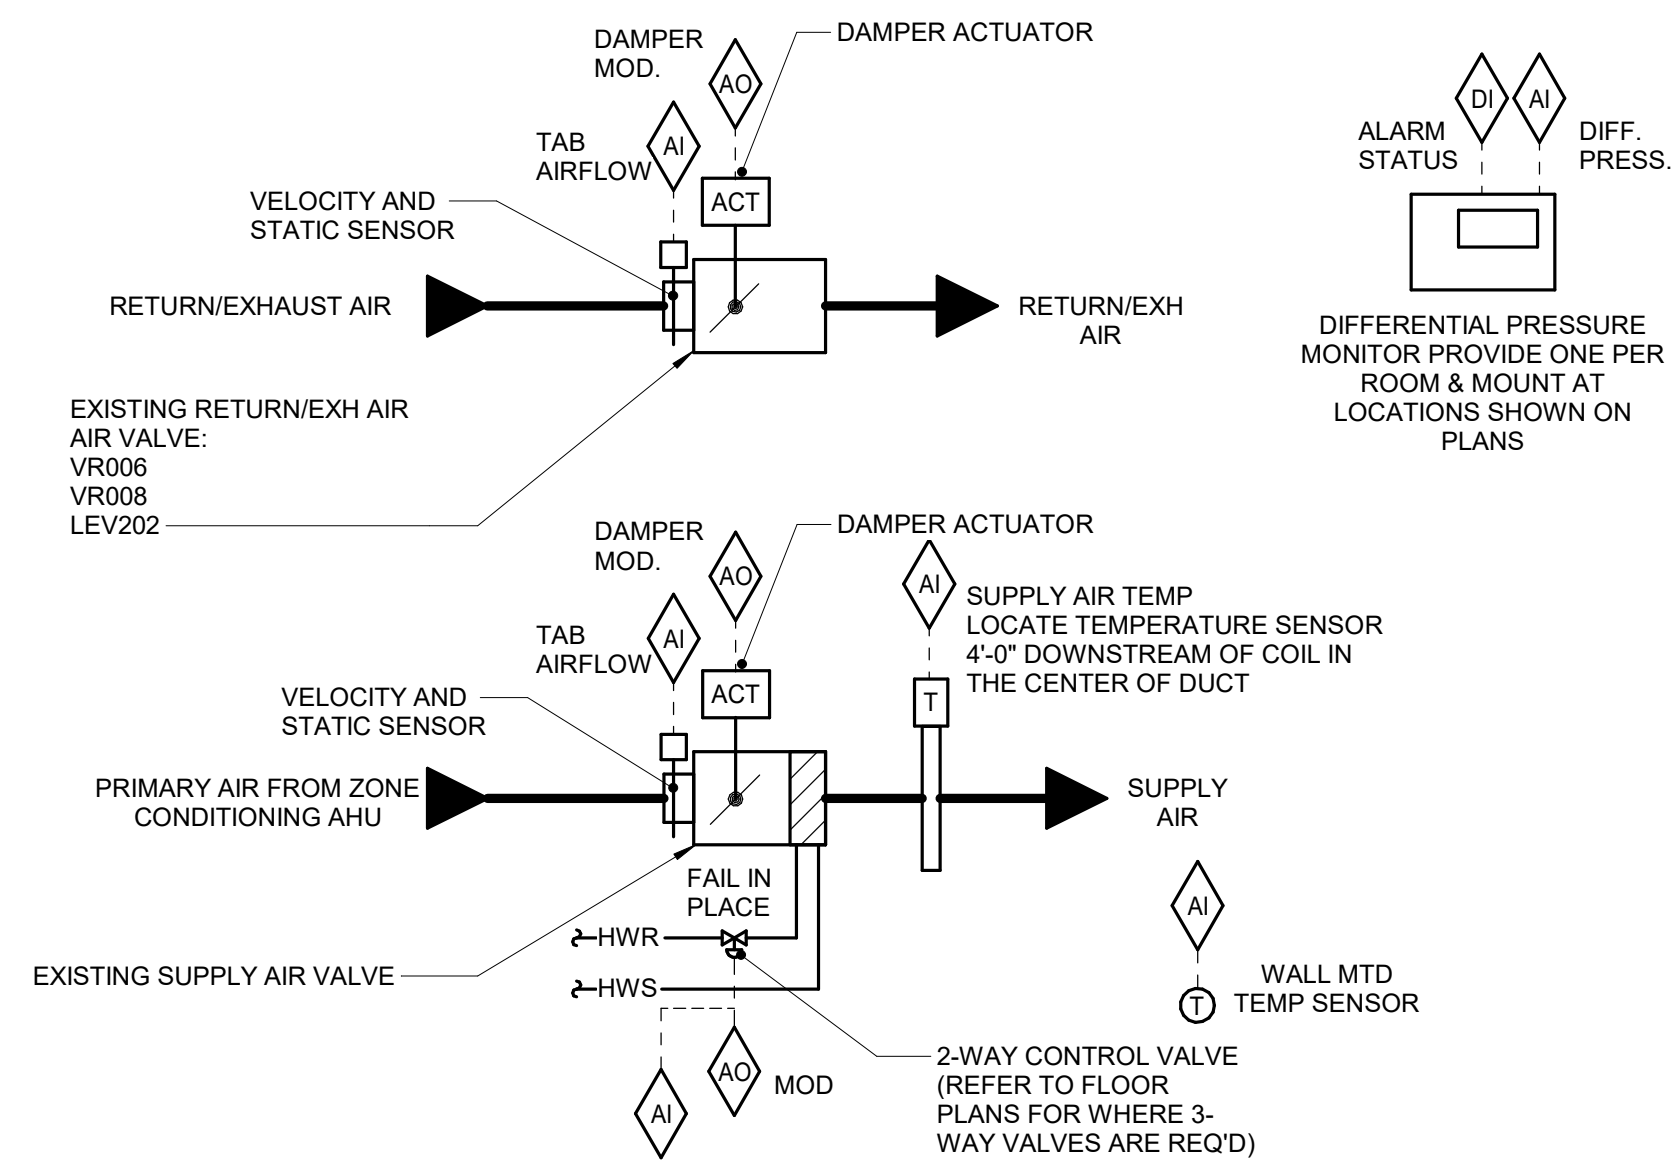

**SEQUENCE OF OPERATION:**


- FMCS AIR VALVE CONTROLLER SHALL MODULATE THE TAB DAMPER AND TAB HW REHEAT COIL CONTROL VALVE TO MAINTAIN SPACE TEMPERATURE OF 72°F (ADJ.) WITH 5°F (ADJ.) DEAD BAND BASED ON A SIGNAL FROM A WALL MOUNTED TEMPERATURE SENSOR. SEE DRAWINGS FOR TEMPERATURE SENSOR REQUIREMENTS. SPACES WITH ADJUSTABLE THERMOSTATS WILL ALLOW A +/- 3°F (ADJ.) OFFSET FROM THE DDC SETPOINT.
- AT FULL COOLING, THE TAB SHALL BE OPEN TO MAXIMUM CFM POSITION. THE REHEAT COIL CONTROL VALVE SHALL BE CLOSED.
- UPON A FALL IN SPACE TEMPERATURE, THE TAB SHALL MODULATE CLOSED UNTIL SPACE SETPOINT IS MAINTAINED, OR UNTIL IT REACHES ITS MINIMUM CFM POSITION.
- UPON A FURTHER FALL IN SPACE TEMPERATURE, THE REHEAT COIL CONTROL VALVE SHALL MODULATE OPEN TO MAINTAIN SPACE SETPOINT UNTIL THE SUPPLY AIR TEMPERATURE IS 20°F ABOVE ROOM TEMPERATURE SETPOINT.
- UPON A FURTHER FALL IN SPACE TEMPERATURE, TAB SHALL OPEN TO MAINTAIN SETPOINT UNTIL TAB AIRFLOW REACHES ITS MAXIMUM HEATING SETTING. THE REHEAT CONTROL VALVE SHALL CONTINUE TO MODULATE OPEN TO MAINTAIN MAXIMUM DELTA T LISTED ABOVE.

**RETURN/EXHAUST TAB SEQUENCE OF OPERATION:**

- FMCS SHALL MODULATE RETURN/EXHAUST TAB DAMPER TO ACHIEVE THE ROOM AT MINIMUM -0.010 OR +0.010
- FMCS SHALL MONITOR EACH ROOM DIFFERENTIAL PRESSURE (DP) AND SHALL DISPLAY THE VALUE ON THE TAB GRAPHICAL SCREEN AT THE OPERATOR WORKSTATION.

**ALARMS, INTERLOCKS & SAFETIES:**

- SEND AN ALARM TO THE FMCS OPERATOR INTERFACE IF THE SPACE TEMPERATURE IS MORE THAN 10°F (ADJ.) ABOVE OR BELOW SETPOINT.
- DIFFERENTIAL PRESSURE MONITOR SHALL INDICATE A LOCAL ALARM IN THE EVENT THE ROOM PRESSURE IS GREATER THAN -0.010 OR +0.010.

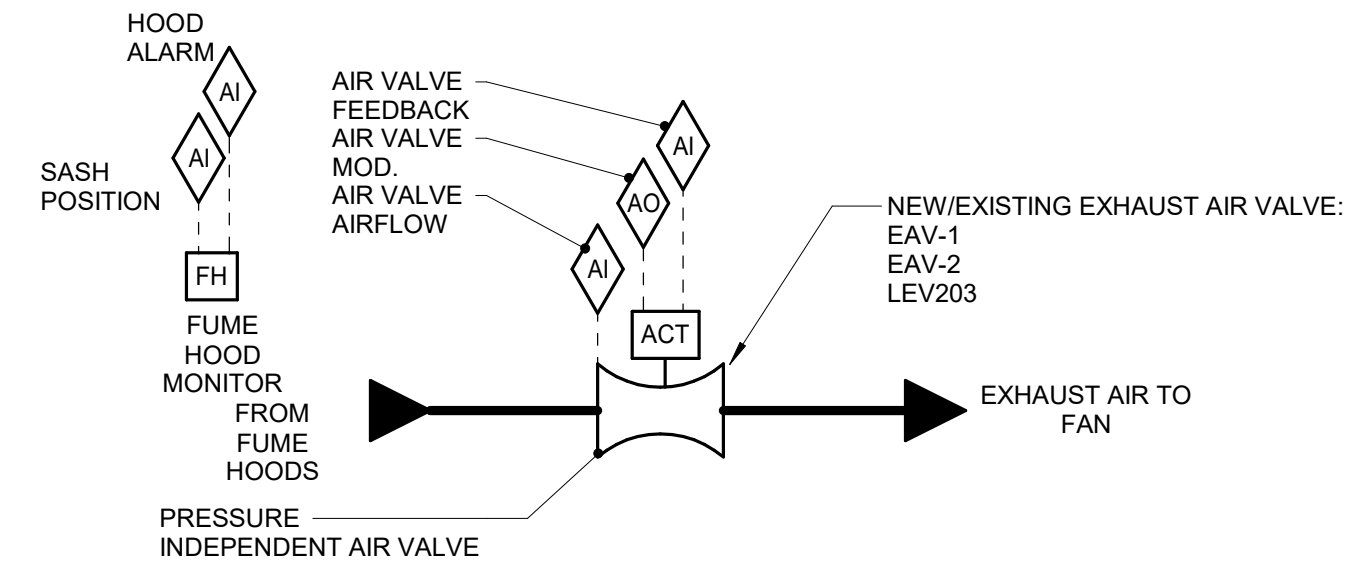

**SEQUENCE OF OPERATION:**

THE FMCS SHALL MODULATE THE EXHAUST AIR VALVE TO MAINTAIN THE MINIMUM FACE VELOCITY ACROSS THE FUME HOOD OPENING FACE VELOCITIES SHALL BE PER THE MANUFACTURERS IOM REQUIREMENTS.


**ALARMS, INTERLOCKS AND SAFETIES:**

- THE FUME HOOD MONITOR SHALL BE CAPABLE OF COMMUNICATING THE FOLLOWING AUDIO (ALL AUDIO ALARMS SHALL BE CAPABLE OF BEING SILENCED) AND VISUAL
- SASH OPENING ABOVE 18"
- SEND AN ALARM TO THE FMCS OPERATOR INTERFACE IF THE DIFFERENTIAL PRESSURE ACROSS THE AIR VALVE DROPS BELOW 0.4" W.C. (ADJ.)

**ALARMS:**

- LOW AIR FLOW
- LOW DIFFERENTIAL STATIC PRESSURE
- SASH OPENING ABOVE 18"
- SEND AN ALARM TO THE FMCS OPERATOR INTERFACE IF THE DIFFERENTIAL PRESSURE ACROSS THE AIR VALVE DROPS BELOW 0.4" W.C. (ADJ.)

**8 FUME HOOD EXHAUST AIR VALVE**  
M9.0 NO SCALE

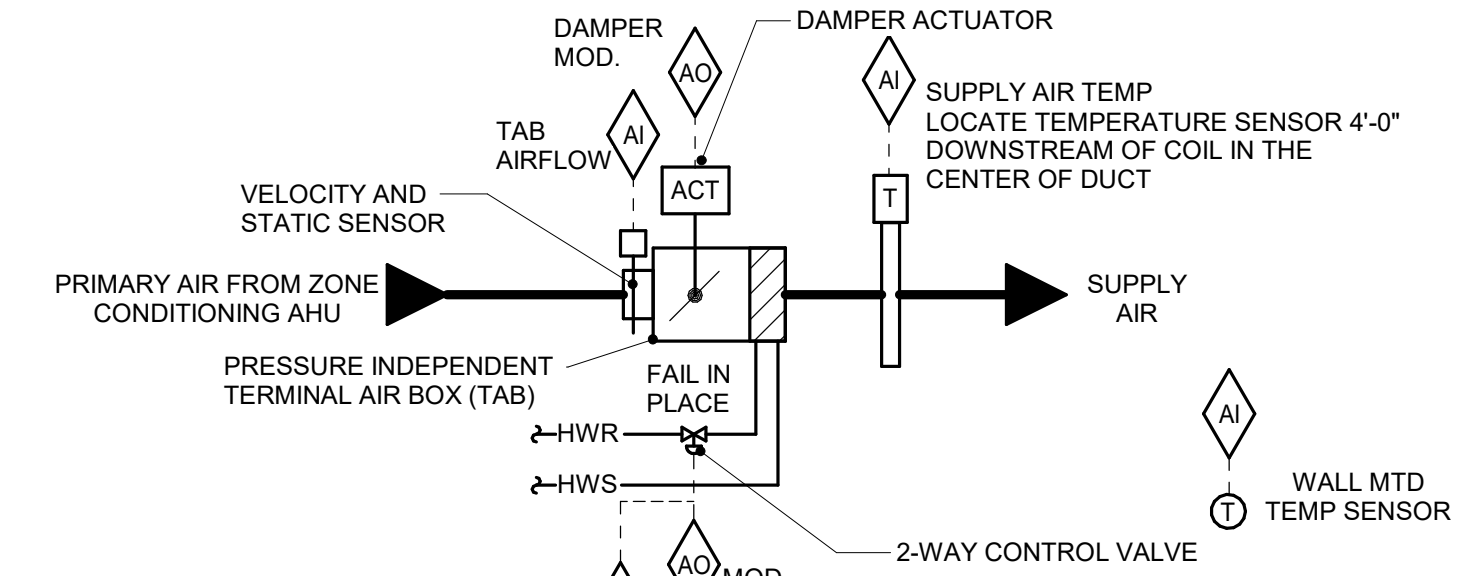

**SEQUENCE OF OPERATION:**

- FMCS TAB CONTROLLER SHALL MODULATE THE TAB DAMPER AND TAB HW REHEAT COIL CONTROL VALVE TO MAINTAIN SPACE TEMPERATURE OF 72°F (ADJ.) WITH 5°F (ADJ.) DEAD BAND BASED ON A SIGNAL FROM A WALL MOUNTED TEMPERATURE SENSOR. SPACES WITH ADJUSTABLE THERMOSTATS WILL ALLOW A +/- 3°F (ADJ.) OFFSET FROM THE DDC SETPOINT.
- AT FULL COOLING, THE TAB SHALL BE OPEN TO MAXIMUM CFM POSITION. THE REHEAT COIL CONTROL VALVE SHALL BE CLOSED.
- UPON A FALL IN SPACE TEMPERATURE, THE TAB SHALL MODULATE CLOSED UNTIL SPACE SETPOINT IS MAINTAINED, OR UNTIL IT REACHES ITS MINIMUM SCHEDULED CFM POSITION PER THE TAB SCHEDULE. THE REHEAT COIL CONTROL VALVE SHALL BE CLOSED.
- UPON A FURTHER FALL IN SPACE TEMPERATURE, THE REHEAT COIL CONTROL VALVE SHALL MODULATE OPEN TO MAINTAIN SPACE SETPOINT UNTIL THE SUPPLY AIR TEMPERATURE IS 20°F ABOVE ROOM TEMPERATURE SETPOINT.
- UPON A FURTHER FALL IN SPACE TEMPERATURE, TAB SHALL OPEN TO MAINTAIN SETPOINT UNTIL TAB AIRFLOW REACHES ITS MAXIMUM HEATING SETTING. THE REHEAT CONTROL VALVE SHALL CONTINUE TO MODULATE OPEN TO MAINTAIN MAXIMUM DELTA T LISTED ABOVE.
- WHEN FLOATING CV'S ARE USED, FMCS SHALL PERFORM AN AUTO-ZERO FUNCTION EVERY NIGHT DURING UNOCCUPIED TIMES. THE FMCS SHALL STAGGER AUTO-ZERO SEQUENCES SO THAT ALL VALVES DO NOT SIMULTANEOUSLY CLOSE.

**ALARMS, INTERLOCKS & SAFETIES:**


SEND AN ALARM TO THE FMCS OPERATOR INTERFACE IF THE SPACE TEMPERATURE IS MORE THAN 10°F (ADJ.) ABOVE OR BELOW SETPOINT.

**9 CONTROL W/ HOT WATER REHEAT - TAB-1**  
M9.0 NO SCALE

**11 AIR VALVE CONTROL W/ HOT WATER REHEAT AND ROOM PRESSURE AIR VALVE CONTROL**  
M9.0 NO SCALE

ADD-1

- Delete: reference to air valve control for all air valves serving Room 234. The existing air valves and pressure controls serving room 234 will remain and be reused.
- Add: Start/Stop and Status points for EF-3. Fan start/stop signal shall be from the hood.
- Add: Status point for EF-1. Fan will run continuously.

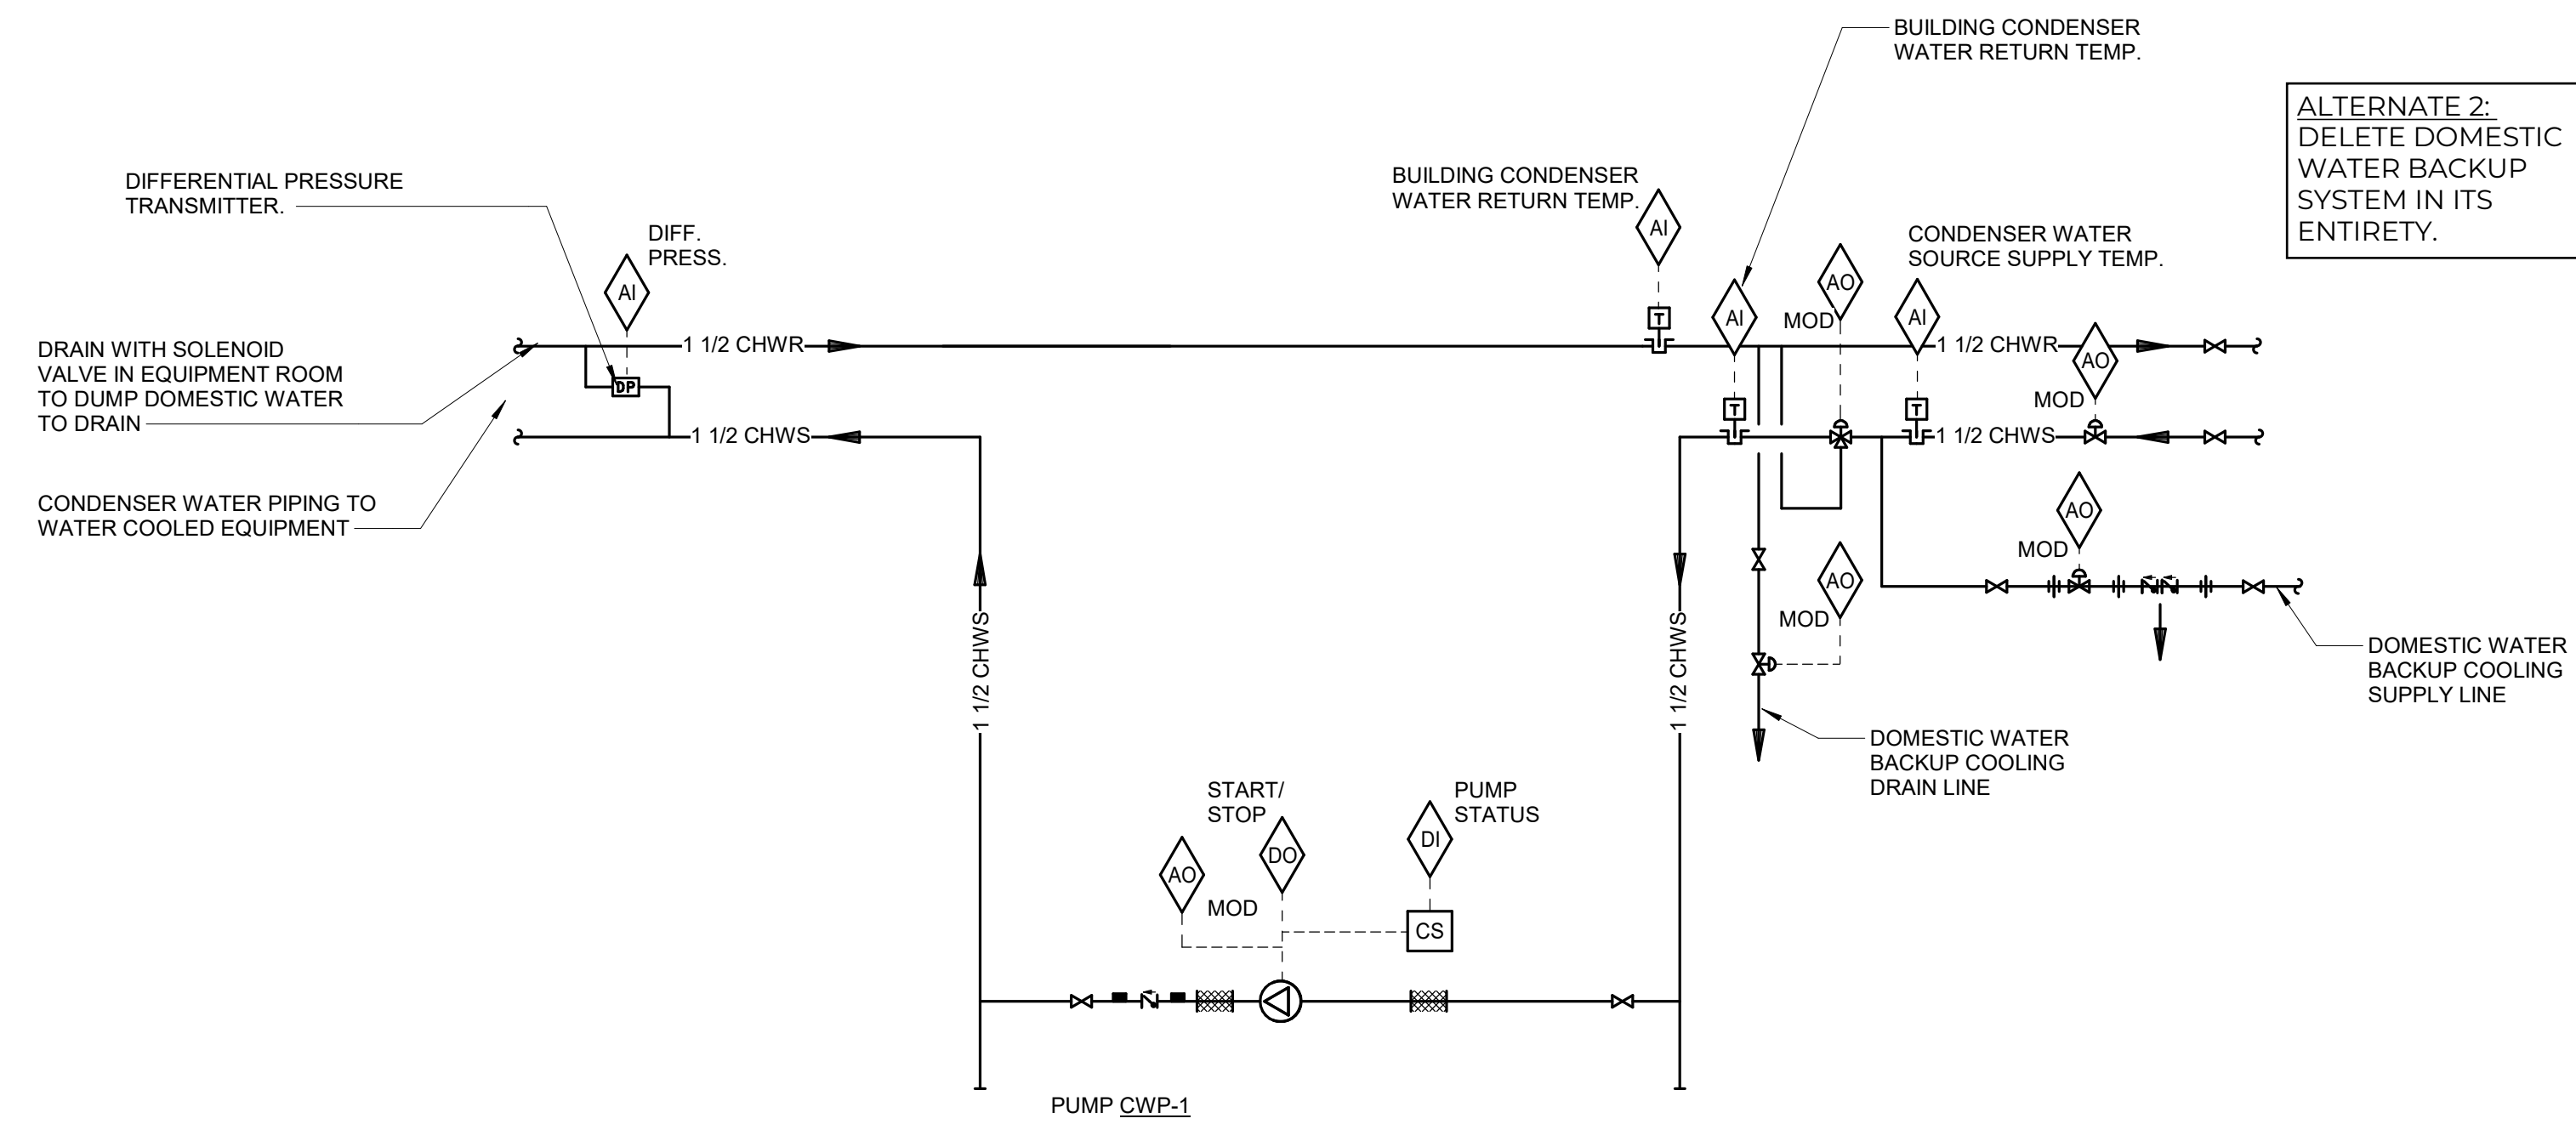

**SEQUENCE OF OPERATION**


ON A CALL FOR COOLING FROM THE HEAT PUMP OR THE LAB PROCESS EQUIPMENT, THE CONDENSER WATER SUPPLY VALVE SHALL OPEN AND THE CONDENSER WATER PUMP CWP-1 SHALL BE ENABLED. THE 3-WAY VALVE SHALL MODULATE TO MAINTAIN 70°F (ADJ.) CONDENSER WATER SUPPLY TEMPERATURE. WHEN THE CALL FOR COOLING IS SATISFIED, THE CONDENSER WATER SUPPLY VALVE SHALL CLOSE AND THE PUMP SHALL BE DISABLED AFTER A 2 MINUTE DELAY. IF THE CONDENSER WATER SUPPLY TEMPERATURE RISES ABOVE 75°F FOR MORE THAN 10 MINUTES, THE FMCS SHALL GENERATE AN ALARM. CLOSE THE CONDENSER WATER SUPPLY VALVE, AND MODULATE THE DOMESTIC WATER BACKUP COOLING SUPPLY AND DRAIN VALVES TO MAINTAIN THE CONDENSER WATER SUPPLY TEMPERATURE AT 70°F.

THE FMCS SHALL MODULATE THE PUMPS SPEED TO MAINTAIN THE DIFFERENTIAL PRESSURE SET POINT. THE DIFFERENTIAL PRESSURE SET POINT SHALL BE DETERMINED BY THE TAB CONTRACTOR DURING SYSTEM BALANCING.

**ALARMS**

- GENERATE AN ALARM THROUGH THE FMCS IF THE PUMP IS ENABLED AND THE PUMP STATUS INDICATES THE PUMP IS NOT RUNNING.
- GENERATE AN ALARM THROUGH THE FMCS IF THE CONDENSER WATER TEMPERATURE IS ABOVE 75°F FOR MORE THAN 10 MINUTES.
- GENERATE AN ALARM THROUGH THE FMCS IF THE DOMESTIC WATER BACK UP VALVE IS OPEN FOR MORE THAN 3 HOURS.

**18 CONDENSER WATER LOOP CONTROL**  
M9.0 NO SCALE

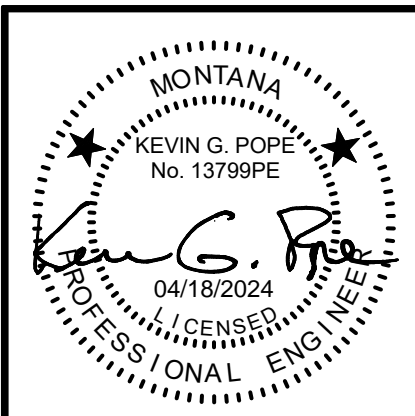

**IMEG**  
1000 27TH STREET  
BILLYS, MT 59001  
P: 406.256.1141  
WWW.IMEG.COM

IMEG CORP. RESERVES PROPRIETARY RIGHTS, INCLUDING COPYRIGHTS, IN ALL INFORMATION AND DATA AND MAKES NO WARRANTY, EXPRESS OR IMPLIED, REGARDING THE ACCURACY, COMPLETENESS, OR AVAILABILITY OF THE INFORMATION. ©2022 IMEG CORP.


**HVAC DIAGRAMS**  
**BARNARD ROOM & QUANTUM FOUNDRY RENOVATION**  
**100% CONSTRUCTION DOCUMENTS**

**HIGH PLAINS ARCHITECTS**  
PHONE (406) 896-0250 | FAX (406) 896-0255  
277 S. BOX 2203 | BILLYS, MT 59103  
WWW.HIGHPLAINSARCHITECTS.COM

DRAWN BY: KWH  
PROJECT#: 22210  
DATE: 04/18/2024

**M9.0**

PL01 STAFF: 4/18/2024 9:40:05 AM

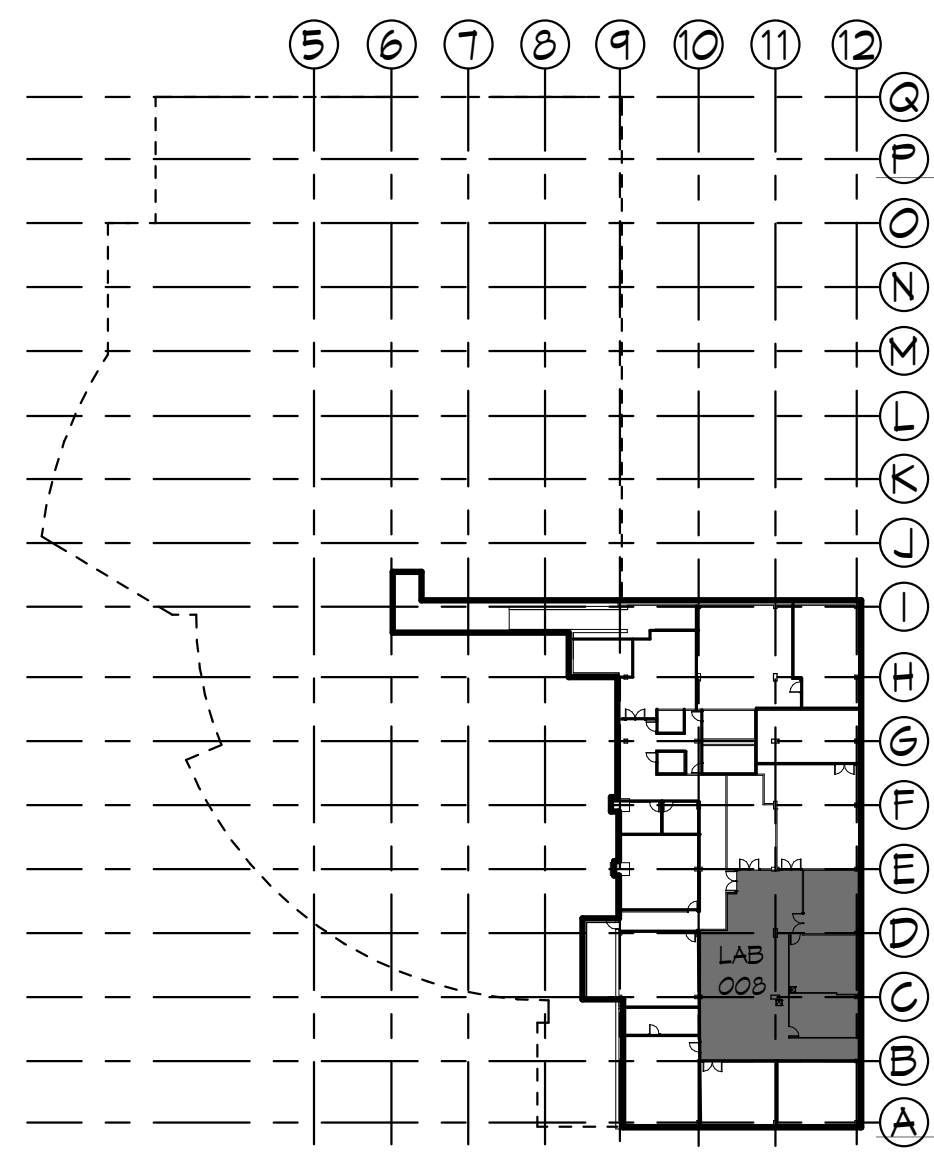

**6 BASEMENT KEY PLAN**  
P2.B 1" = 60'-0"




**16 BASEMENT ROOM 008 PLUMBING PLAN**  
P2.B 1/4" = 1'-0"

**KEYNOTES**

- 100 PROVIDE HIGH PRESSURE FLEXIBLE STAINLESS STEEL HELIUM LINES.
- 118 ROUTE 1/2" N OVERHEAD TO EACH OPTICAL TABLE AND PROVIDE QUICK DISCONNECT. ROUTE 1/2" N TO EACH GLOVE BOX AND PROVIDE CONNECT TO LAB EQUIPMENT PER MANUFACTURES INSTALLATION INSTRUCTIONS.
- 119 ROUTE 1-1/2" VAC OVERHEAD TO EACH OPTICAL TABLE AND PROVIDE QUICK DISCONNECT.
- 123 PROVIDE NITROGEN GAS MANIFOLD. SEE DETAILS FOR MORE INFORMATION.
- 130 ROUTE BACK TO EXISTING NITROGEN MAIN.
- 300 ROUTE SANITARY PIPING FROM FLOOR SINK (FS-1) AND CONNECT INTO EXISTING SANITARY PIPING. SAWCUT AND PATCH CONCRETE AS NEEDED FOR CONNECTION. ROUTE VENT PIPING FROM FLOOR SINK INTO EXISTING VENT PIPING SYSTEM.
- 301 PROVIDE DRAIN PUMP IN CABINET SPACE NEXT TO SINK AND ROUTE PUMPED SANITARY TO EXISTING SANITARY DRAIN.
- 302 PROVIDE MOISTURE DETECTION DEVICE WITH ALARM.
- 303 REROUTE EXISTING CONDENSATE PIPE THAT DRAINED TO EXISTING FLOOR DRAIN TO NEW FLOOR SINK.
- 304 PROVIDE FLOOR DRAIN FOR EMERGENCY SHOWER. SAWCUT AND PATCH FLOOR AS NEEDED TO CONNECT NEW SANITARY PIPING FROM THE EMERGENCY SHOWER AND FLOOR DRAIN TO EXISTING SANITARY SYSTEM. ROUTE VENT FROM FLOOR DRAIN AND EMERGENCY SHOWER TO EXISTING VENT SYSTEM. ROUTE 3/4" COLD AND HOT WATER FROM MAINS TO EMERGENCY SHOWER MIXING VALVE. ISOLATION VALVES SHALL BE LOCKED OPEN. CONNECT RECIRCULATION PIPE INTO BUILDING RECIRCULATION SYSTEM. PROVIDE BALLANCING VALVE WITH CHECK VALVE AND SET RECIRCULATION FLOW TO 0.5 GPM.
- 305 ROUTE CONDENSATE FROM HEAT PUMP (WCU-1) TO NEW FLOOR SINK AT A MINIMUM SLOPE OF 1/8 INCH PER FOOT.
- 306 ROUTE DOMESTIC COLD, HOT AND HOT RECIRC TO NEAREST MAINS AND TAP MAINS WITH ISOLATION VALVES. COLD WATER TO BE ROUTED TO 1-1/2" OR LARGER COLD WATER MAIN.
- 307 SEE CONDENSER WATER LOOP (DOMESTIC) DETAIL FOR COLD WATER SUPPLY AND DRAIN INFORMATION FOR CONDENSER WATER LOOP.
- 400 ADJUST SPRINKLER HEADS AND PIPING FOR NEW CEILING AND WALLS. COORDINATE LAYOUT WITH EXISTING AND NEW MECHANICAL AND LIGHTING EQUIPMENT.
- 401 NEW FIRE PROTECTION WORK AND MATERIALS ARE TO MATCH THE EXISTING SYSTEM, UNLESS OTHERS BE REQUIRED BY THE AHJ. THIS SHALL INCLUDE BUT IS NOT LIMITED TO PIPING, FITTINGS, SPRINKLERS AND PIPE IDENTIFICATION. ALL MATERIALS SHALL BE UL LISTED AND INSTALLED PER NFPA.
- 402 PROVIDE SPRINKLER COVERAGE ABOVE AND BELOW CLOUD CEILINGS, IN ACCORDANCE WITH NFPA 13. PROTECTION ABOVE CLOUD CEILINGS TO BE PROVIDED FROM EXISTING SYSTEM SPRINKLERS. EXISTING SPRINKLERS TO BE RELOCATED ONLY AS REQUIRED BY NFPA 13. FOR SPRINKLER PROTECTION BELOW THE CLOUD CEILING, ROUTE HARD LINES FROM EXISTING BRANCH LINES TO THE CLOUD CEILINGS AND INSTALL QUICK RESPONSE PENDANT SPRINKLERS.

**PLUMBING GENERAL NOTES:**

- A. SEE ARCHITECTURAL PLANS FOR LOCATION OF LAB EQUIPMENT.
- B. CONTRACTOR TO COORDINATE WITH LAB EQUIPMENT FOR EXACT LOCATION OF CONNECTIONS TO EQUIPMENT. EQUIPMENT WILL INCLUDE THE FOLLOWING
  - GLOVEBOX TRAIN
  - OPTICool CRYOSTAT AND OPTICAL TABLE
  - CHARACTERIZATION BOX AND OPTICAL TABLE
  - MONTANA INSTRUMENTS'S 5100 CRYOSTAT AND OPTICAL TABLE
  - LOW-TEMPERATURE AFM, NANO-OPTICAL MICROSCOPE AND OPTICAL TABLE

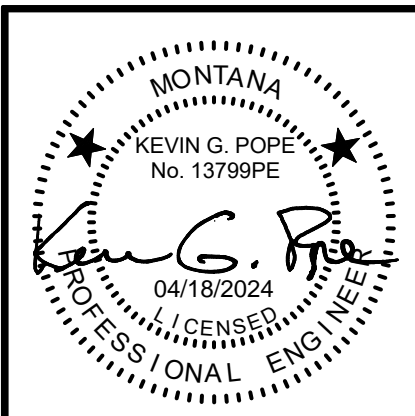

**IMEG**  
107N 27TH STREET  
BILLINGS, MT 05011  
P: 406.256.1141  
www.imeg.com

IMEG CORP. RESERVES PROPRIETARY RIGHTS, INCLUDING COPYRIGHTS. ANY AND ALL INFORMATION CONTAINED HEREIN IS THE EXCLUSIVE PROPERTY OF IMEG CORP. AND WILL NOT BE REPRODUCED, COPIED, OR TRANSMITTED IN ANY FORM OR BY ANY MEANS, WITHOUT THE WRITTEN PERMISSION AND PARTICIPATION OF IMEG CORP. ©2022 IMEG CORP.

PROJECT #2208970.00  
REF. SCALE IN INCHES

**BASEMENT ROOM 008 PLUMBING PLAN**  
**BARNARD ROOM 8 QUANTUM FOUNDRY RENOVATION**  
**100% CONSTRUCTION DOCUMENTS**


**HIGH PLAINS ARCHITECTS**  
PHONE (406) 896-0250 | FAX (406) 896-0255  
277 S. G. BOX 2203 | BILLINGS, MT 59103  
www.highplainsarchitects.com




DRAWN BY: KJB  
PROJECT#: 22210  
DATE: 04/18/2024

**P2.B**

PLOT STAFF: 4/18/2024 9:40:16 AM

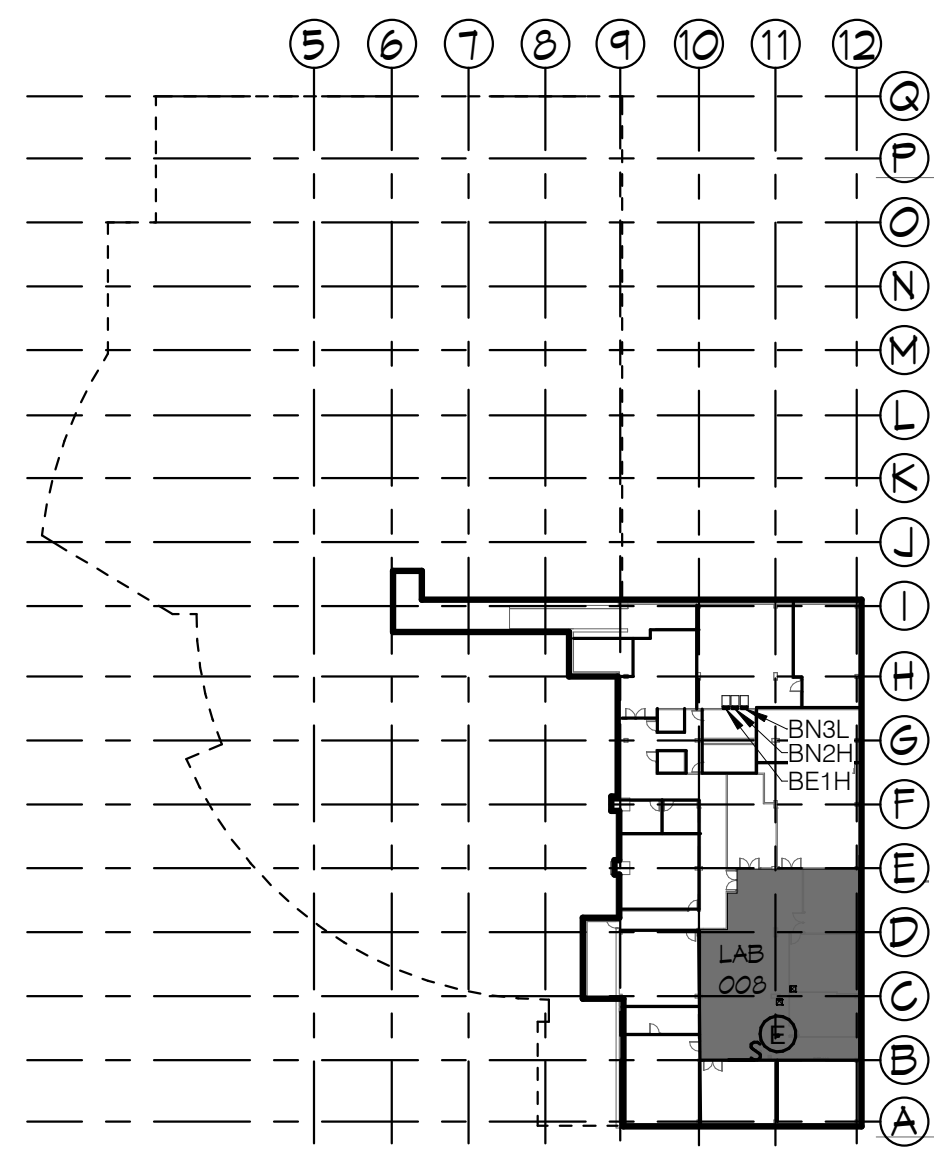

**6 BASEMENT KEY PLAN**  
E2.B  
1" = 20'-0"

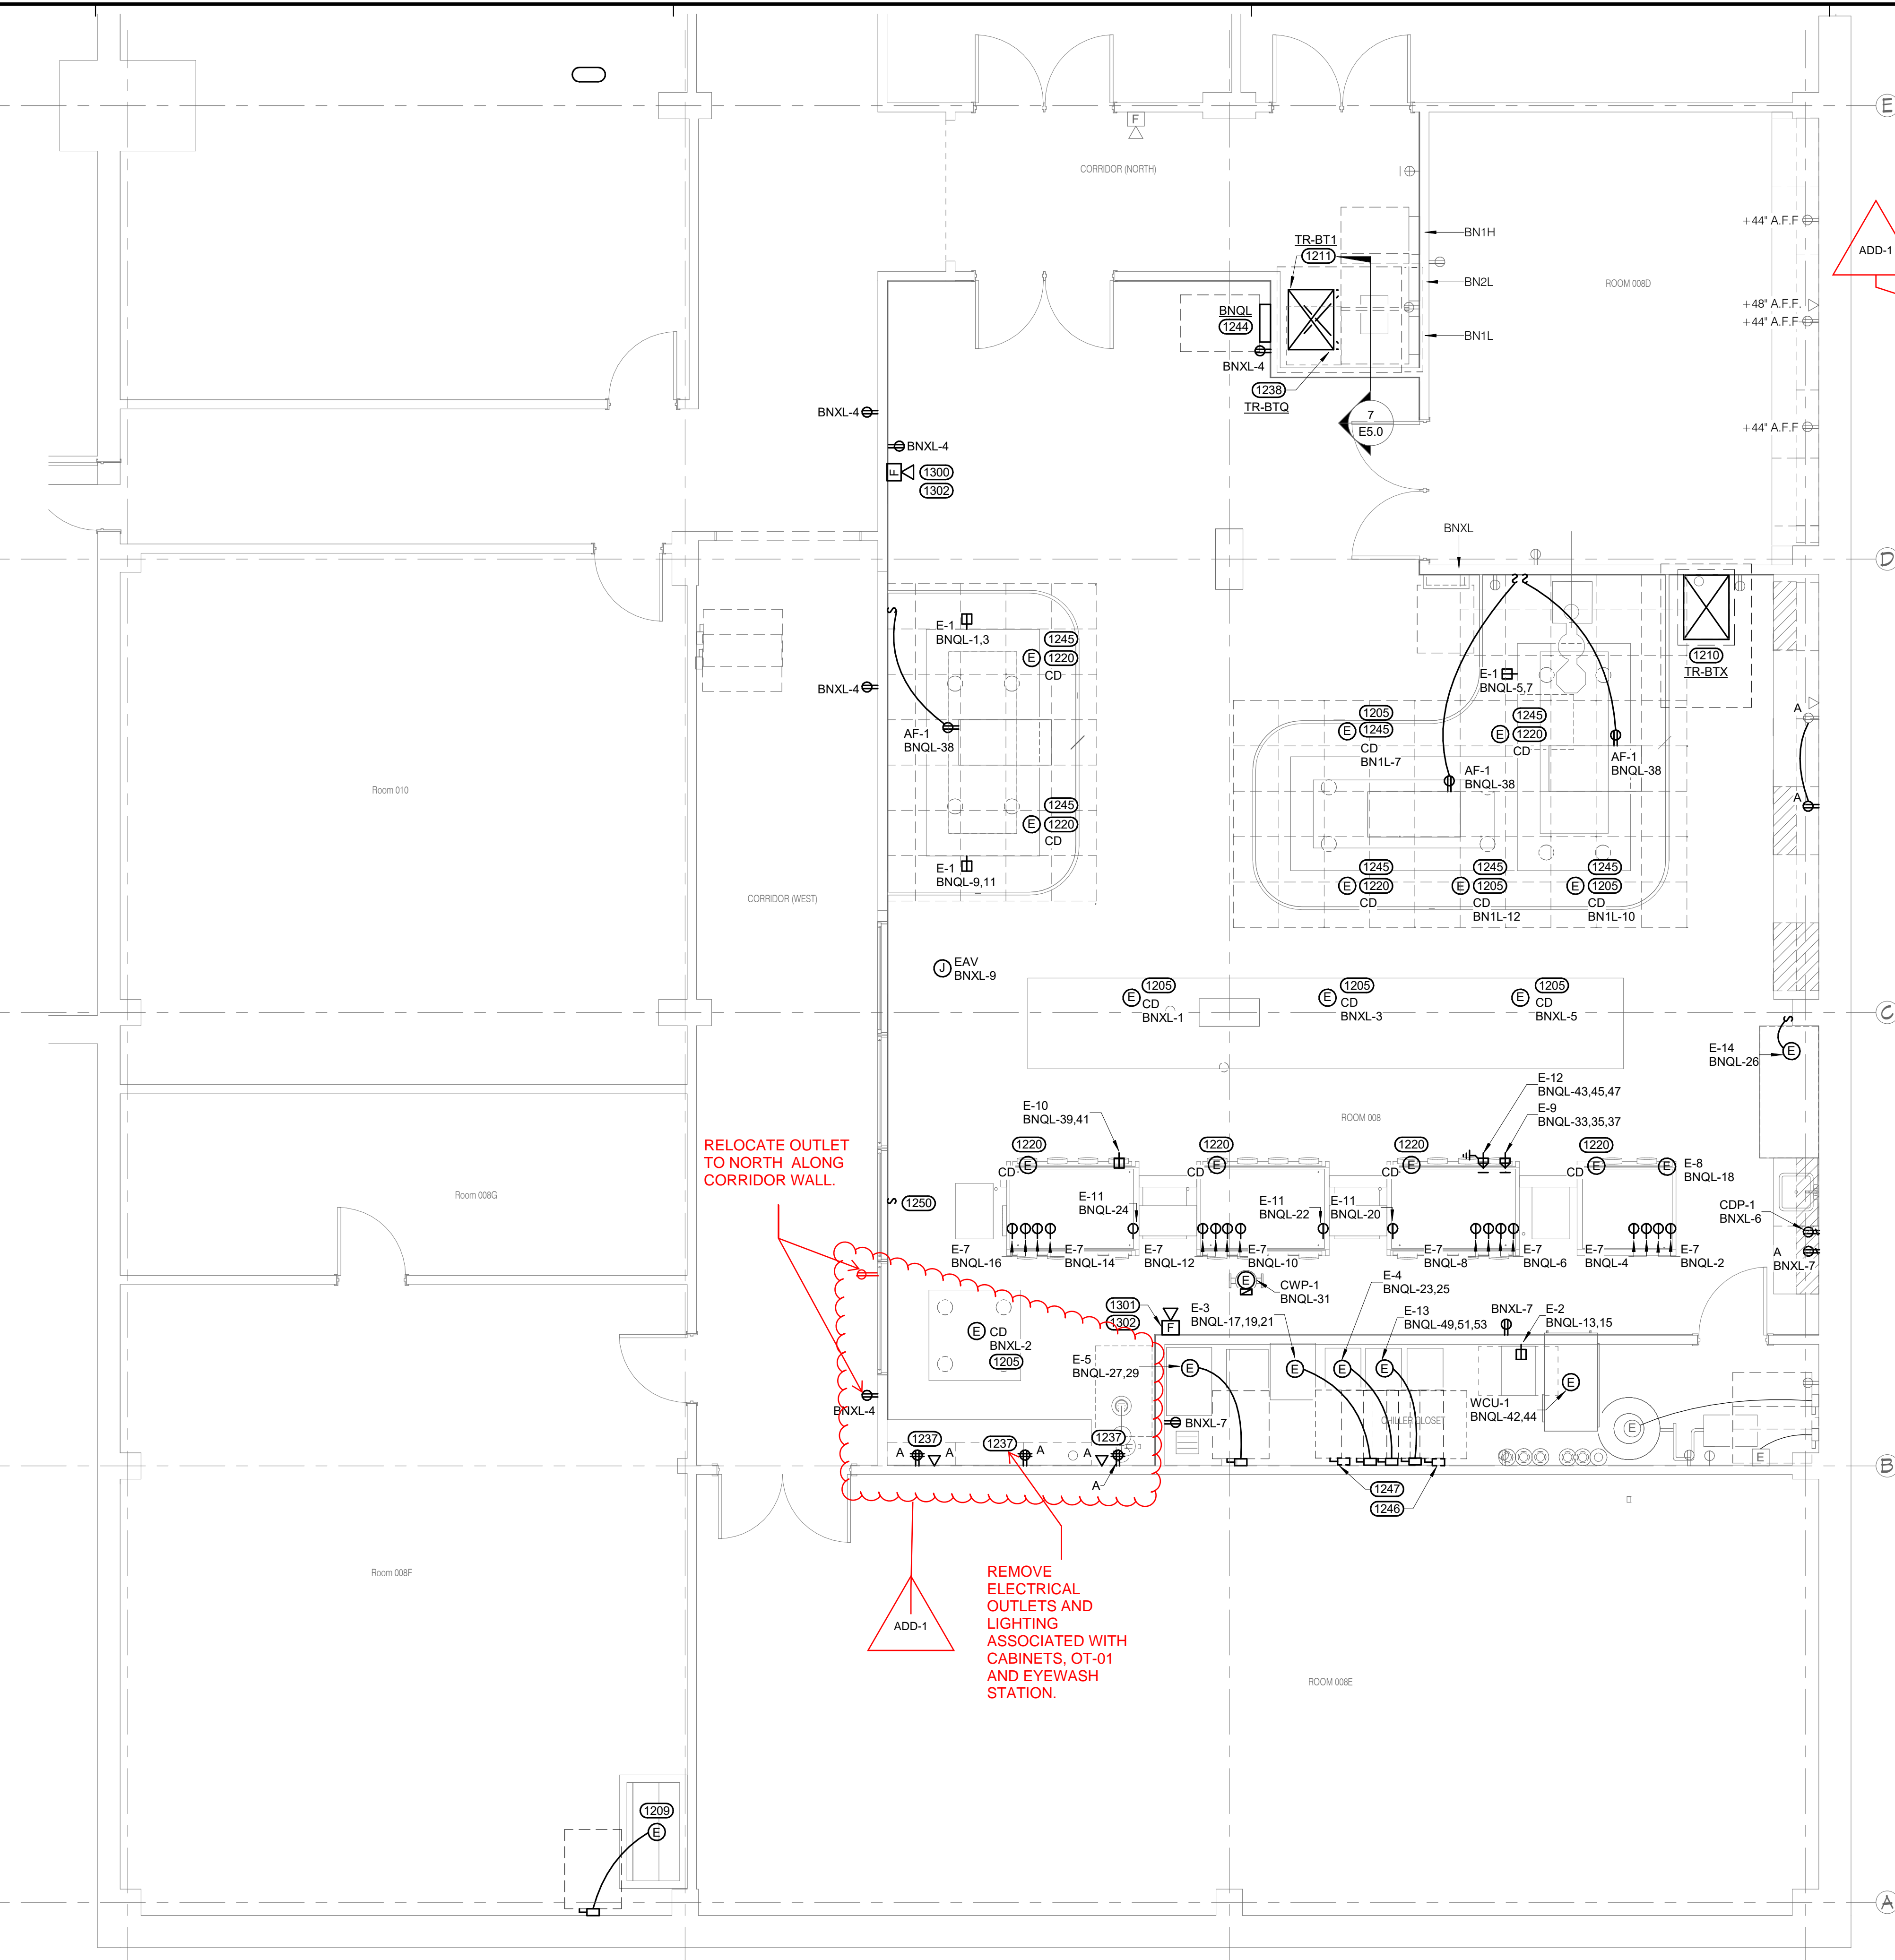

**16 BASEMENT ROOM 008 POWER & SYSTEMS PLAN**  
E2.B  
1/4" = 1'-0"

**ELECTRICAL GENERAL NOTES:**

1. NEW DEVICES SHOWN SHALL BE SURFACE MOUNTED AND FED WITH SURFACE MOUNTED CONDUIT.
2. EC SHALL VERIFY ALL CONNECTION TYPES WITH LAB EQUIPMENT AND PROVIDE MOCK UP OF LAB EQUIPMENT FOR APPROVAL BY MSU PRIOR TO FINAL INSTALLATION.
3. ALL NEW WORK SHALL MATCH EXISTING SEISMIC BRACING AND CODE REQUIREMENTS USED FOR PREVIOUS WORK FOR THIS BUILDING.
4. DEVICES MOUNTED TO TABLES OR SUPPORTING STRUCTURES SHALL HAVE LOCATIONS AND CONDUIT ROUTING COORDINATED WITH MSU.
5. REINSTALL EXISTING WIRELESS ACCESS POINTS SAVED DURING DEMOLITION.
6. ALL EXISTING TECHNOLOGY CABLING WITHIN THE REMODEL AREA SHALL BE INVESTIGATED BY UNIVERSITY I.T. AND UPGRADED AS NECESSARY. COORDINATE ACCESS AND PHASING WITH UNIVERSITY I.T.
7. ALL DATA CONDUIT SHALL BE ROUTED TO ACCESSIBLE CORRIDOR CEILING.

**KEYNOTES**


- 1205 PROVIDE CORD DROP WITH DOUBLE DUPLEX RECEPTACLE. SEE DROP CORD DETAIL ON E5.0. COORDINATE EXACT LOCATION WITH ARCHITECT AND OWNER PRIOR TO ROUGH IN.
- 1209 INSTALL EXISTING DISCONNECT FOR RELOCATED FUME HOOD SAVED DURING DEMOLITION. EXTEND EXISTING CIRCUIT SAVED DURING DEMOLITION AND RECONNECT FUME HOOD. COORDINATE EXACT LOCATION WITH ARCHITECT.
- 1210 EXISTING TRANSFORMER SHALL BE MOUNTED AGAINST PARTIAL WALL WITH TRAPEZE MOUNTING SUPPORTS. ELEVATION AND CLEARANCES SHALL BE COORDINATED WITH ARCHITECT PRIOR TO THE START OF WORK. PROVIDE NEW SECONDARY WIRING TO PANELS BN1L AND BN2L. REFER TO TRANSFORMER ELEVATION DETAIL, TRANSFORMER MOUNTING TRAPEZE DETAIL ON E5.0 AND ONE-LINE DIAGRAM FOR ADDITIONAL ELECTRICAL REQUIREMENTS AND INFORMATION.
- 1211 EXISTING 45KVA TRANSFORMER SAVED DURING DEMOLITION SHALL BE REFEED FROM NEW 70A3P BREAKER IN EXISTING PANEL BN2H LOCATED IN ROOM 001. TRANSFORMER SHALL BE TRAPEZE MOUNTED ABOVE THE NEW 112.5KVA TRANSFORMER. ELEVATION AND CLEARANCES SHALL BE COORDINATED WITH ARCHITECT PRIOR TO THE START OF WORK. PROVIDE NEW SECONDARY WIRING TO PANELS BN1L AND BN2L. REFER TO TRANSFORMER ELEVATION DETAIL, TRANSFORMER MOUNTING TRAPEZE DETAIL ON E5.0 AND ONE-LINE DIAGRAM FOR ADDITIONAL ELECTRICAL REQUIREMENTS AND INFORMATION.
- 1220 REINSTALL EXISTING DROP CORD SAVED DURING DEMOLITION AND EXTEND EXISTING CIRCUIT SAVED DURING DEMOLITION AND RECONNECT. COORDINATE EXACT LOCATIONS WITH ARCHITECT AND OWNER PRIOR TO ROUGH IN.
- 1237 RELOCATE EXISTING POWER OUTLET(S) TO ABOVE COUNTER. EXTEND WIRE AND CONDUIT AS NECESSARY FOR RELOCATION. FOR TELECOM OUTLET, PROVIDE 4"x4" BACKBOX WITH SINGLE GANG MUDRING AND 1-1/4" C WITH PULL STRING TO CEILING SPACE FOR FUTURE MSU I.T. CABLING. COORDINATE EXACT REQUIREMENTS WITH MSU I.T. PRIOR TO START OF WORK.
- 1238 PROVIDE NEW TRANSFORMER MOUNTED SECURELY TO THE FLOOR, UNDER TRAPEZE MOUNTED 45KVA TRANSFORMER. REFER TO TRANSFORMER ELEVATION DETAIL, ON E5.0 AND ONE-LINE DIAGRAM FOR ADDITIONAL ELECTRICAL REQUIREMENTS AND INFORMATION.
- 1244 PROVIDE NEW PANEL BNXL REFER TO ONE-LINE DIAGRAM FOR ADDITIONAL ELECTRICAL REQUIREMENTS AND INFORMATION.
- 1245 DROP CORD TO BYPASS OVERHEAD SHELVING. COORDINATE RECEPTACLE HEIGHT WITH OWNER PRIOR TO INSTALLATION.
- 1246 SPACE FOR FUTURE DISCONNECT FOR FUTURE AFM COMPRESSOR. SPACE FOR FUTURE DISCONNECT FOR FUTURE AFM CHILLER.
- 1250 PROVIDE ON/OFF WALL SWITCH TO CONTROL GLOVE TRAIN EXHAUST FAN. PROVIDE NON FADING LABEL ON SWITCH "GLOVE TRAIN EXHAUST". COORDINATE EXACT LOCATION WITH MECHANICAL CONTRACTOR AND OWNER.
- 1300 MATCH EXISTING DEVICE MANUFACTURER AND TIE INTO EXISTING BUILDING FIRE ALARM SYSTEM.
- 1301 RELOCATE EXISTING FIRE ALARM HORN STROBE SAVED DURING DEMOLITION. EXTEND EXISTING CONDUITS AND WIRES AS NECESSARY TO MAKE SYSTEM FULLY OPERATIONAL.
- 1302 VERIFY THAT THE EXISTING FIRE ALARM SYSTEM IS OPERATING PROPERLY AND DOCUMENT ALL DEFICIENCIES PRIOR TO CONSTRUCTION. CONFIRM THAT THERE IS ADEQUATE CAPACITY ON EXISTING CIRCUITS FOR THIS WORK AND UPGRADE THE PANEL AS NECESSARY. PROVIDE BATTERY AND CIRCUIT LOAD CALCULATIONS AS REQUIRED. COMPLETE THE FIRE ALARM PROGRAMMING, UPDATE RELATED GRAPHIC DISPLAYS, AND THEN TEST THE NEW CIRCUITS AT THE END OF THE PROJECT.

4/18/2024

**IMEG**  
100 WADSWORTH STREET  
BILLYBUSH, MT 59101  
P: 406.256.1141  
WWW.IMEGARCHITECTS.COM  
PROJECT #220870.00  
REF. SCALE IN INCHES

**BASEMENT ROOM 008 POWER & SYSTEMS PLAN**  
**BARNARD ROOM 8 QUANTUM FOUNDRY RENOVATION**  
**100% CONSTRUCTION DOCUMENTS**


**HIGH PLAINS ARCHITECTS**  
PHONE (406) 896-0250 | FAX (406) 896-0255  
277 P.C. BOX 2203 | BILLYBUSH, MT 59103  
WWW.HIGHPLAINSARCHITECTS.COM

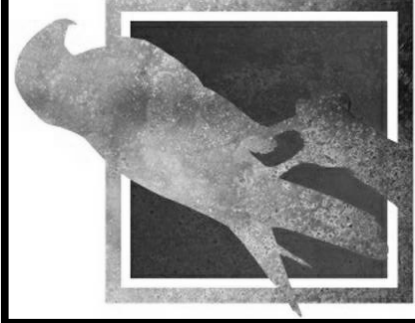

DRAWN BY: KJC  
PROJECT#: 22210  
DATE: 04/18/2024

**E2.B**

PLOT STAFF: 5/15/2024 11:19:42 AM

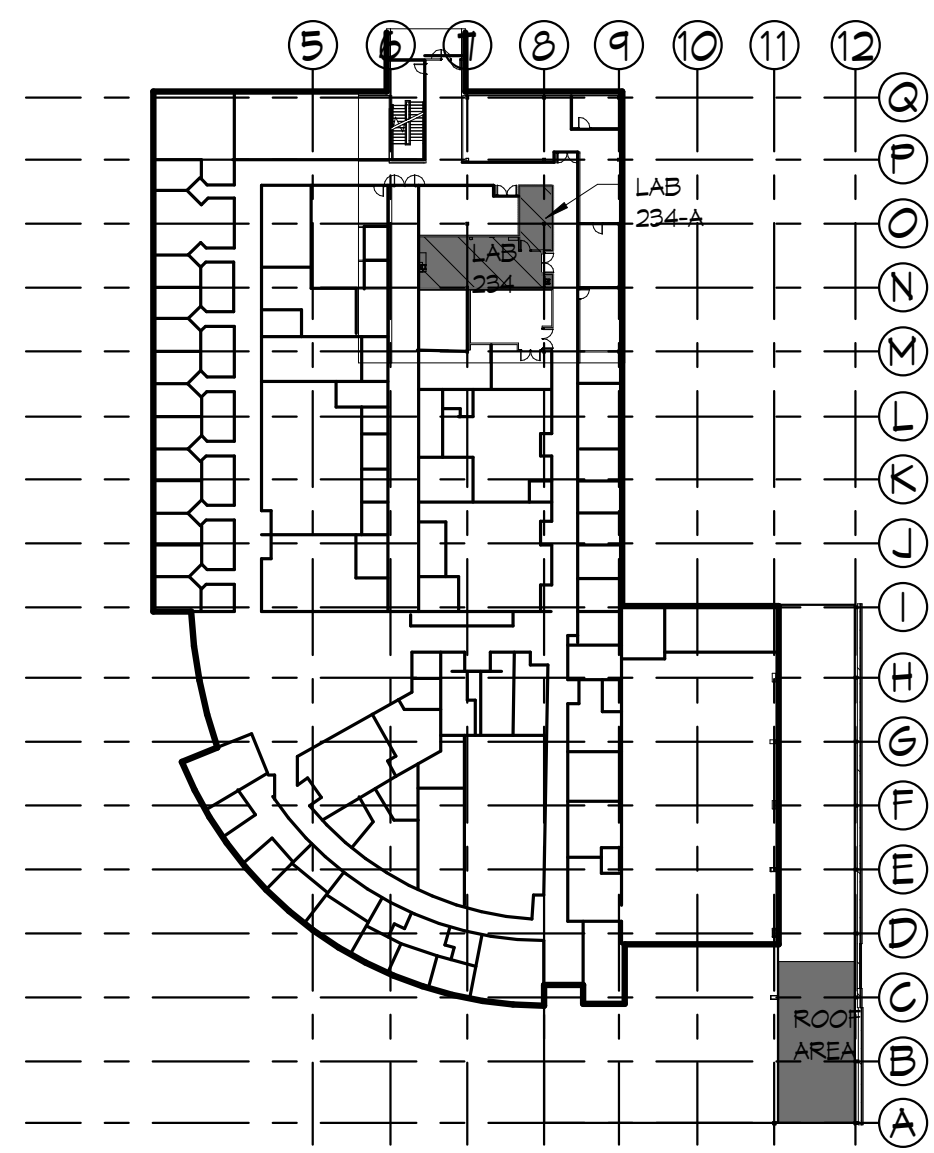


**6 SECOND FLOOR KEY PLAN**  
E2.2 1" = 60'-0"

**ELECTRICAL GENERAL NOTES:**


- NEW DEVICES SHOWN SHALL BE SURFACE MOUNTED AND FED WITH SURFACE MOUNTED CONDUIT.
- EC SHALL VERIFY ALL CONNECTION TYPES WITH LAB EQUIPMENT AND PROVIDE MOCK UP OF LAB EQUIPMENT FOR APPROVAL BY MSU PRIOR TO FINAL INSTALLATION.
- EXISTING DEVICES TO REMAIN ARE CURRENTLY CIRCUITED TO PANEL 2N11L.
- ALL NEW WORK SHALL MATCH EXISTING SEISMIC BRACING AND CODE REQUIREMENTS USED FOR PREVIOUS WORK FOR THIS BUILDING.
- ALL DATA CONDUIT SHALL BE ROUTED TO ACCESSIBLE CORRIDOR CEILING.**

**KEYNOTES**

- 1205 PROVIDE CORD DROP WITH DOUBLE DUPLEX RECEPTACLE. SEE DROP CORD DETAIL ON E5.0. COORDINATE EXACT LOCATION WITH ARCHITECT AND OWNER PRIOR TO ROUGH IN.
- 1222 PROVIDE LEGRAND 2000 SERIES PLUGMOLD OR APPROVED EQUAL WITH SIMPLEX RECEPTACLES SPACED AT 2' O.C. WITH ALTERNATING CIRCUITS. MOUNT ABOVE COUNTER.
- 1225 EXISTING RECEPTACLE AND DATA JACK TO REMAIN FOR USE WITH NEW WEATHER-O-METER.
- 1227 EXISTING RECEPTACLE TO REMAIN FOR USE WITH ULTRASONIC EQUIPMENT.
- 1231 PROVIDE 4"x4" BACKBOX WITH SINGLE GANG MUDRING AND 1-1/4" C WITH PULL STRING TO CEILING SPACE FOR FUTURE MSU I.T. CABLING. COORDINATE EXACT REQUIREMENTS WITH MSU I.T. PRIOR TO START OF WORK.
- 1235 PROVIDE NEW CIRCUIT BREAKERS WITHIN PANEL TO SUPPORT RENOVATION. PROVIDE FILLER PLATES WHERE NECESSARY FOR UNUSED SPACES WHERE PREVIOUS CIRCUIT BREAKERS HAVE BEEN REMOVED. SEE PANEL SCHEDULE FOR ADDITIONAL INFORMATION.
- 1236 EXISTING TC CONTROL PANEL AND THERMOSTAT RELOCATED BY MC, EC TO RECONNECT AND EXTEND EXISTING BRANCH CIRCUIT TO POWER AS NEEDED TO MAKE SYSTEMS OPERATIONAL.

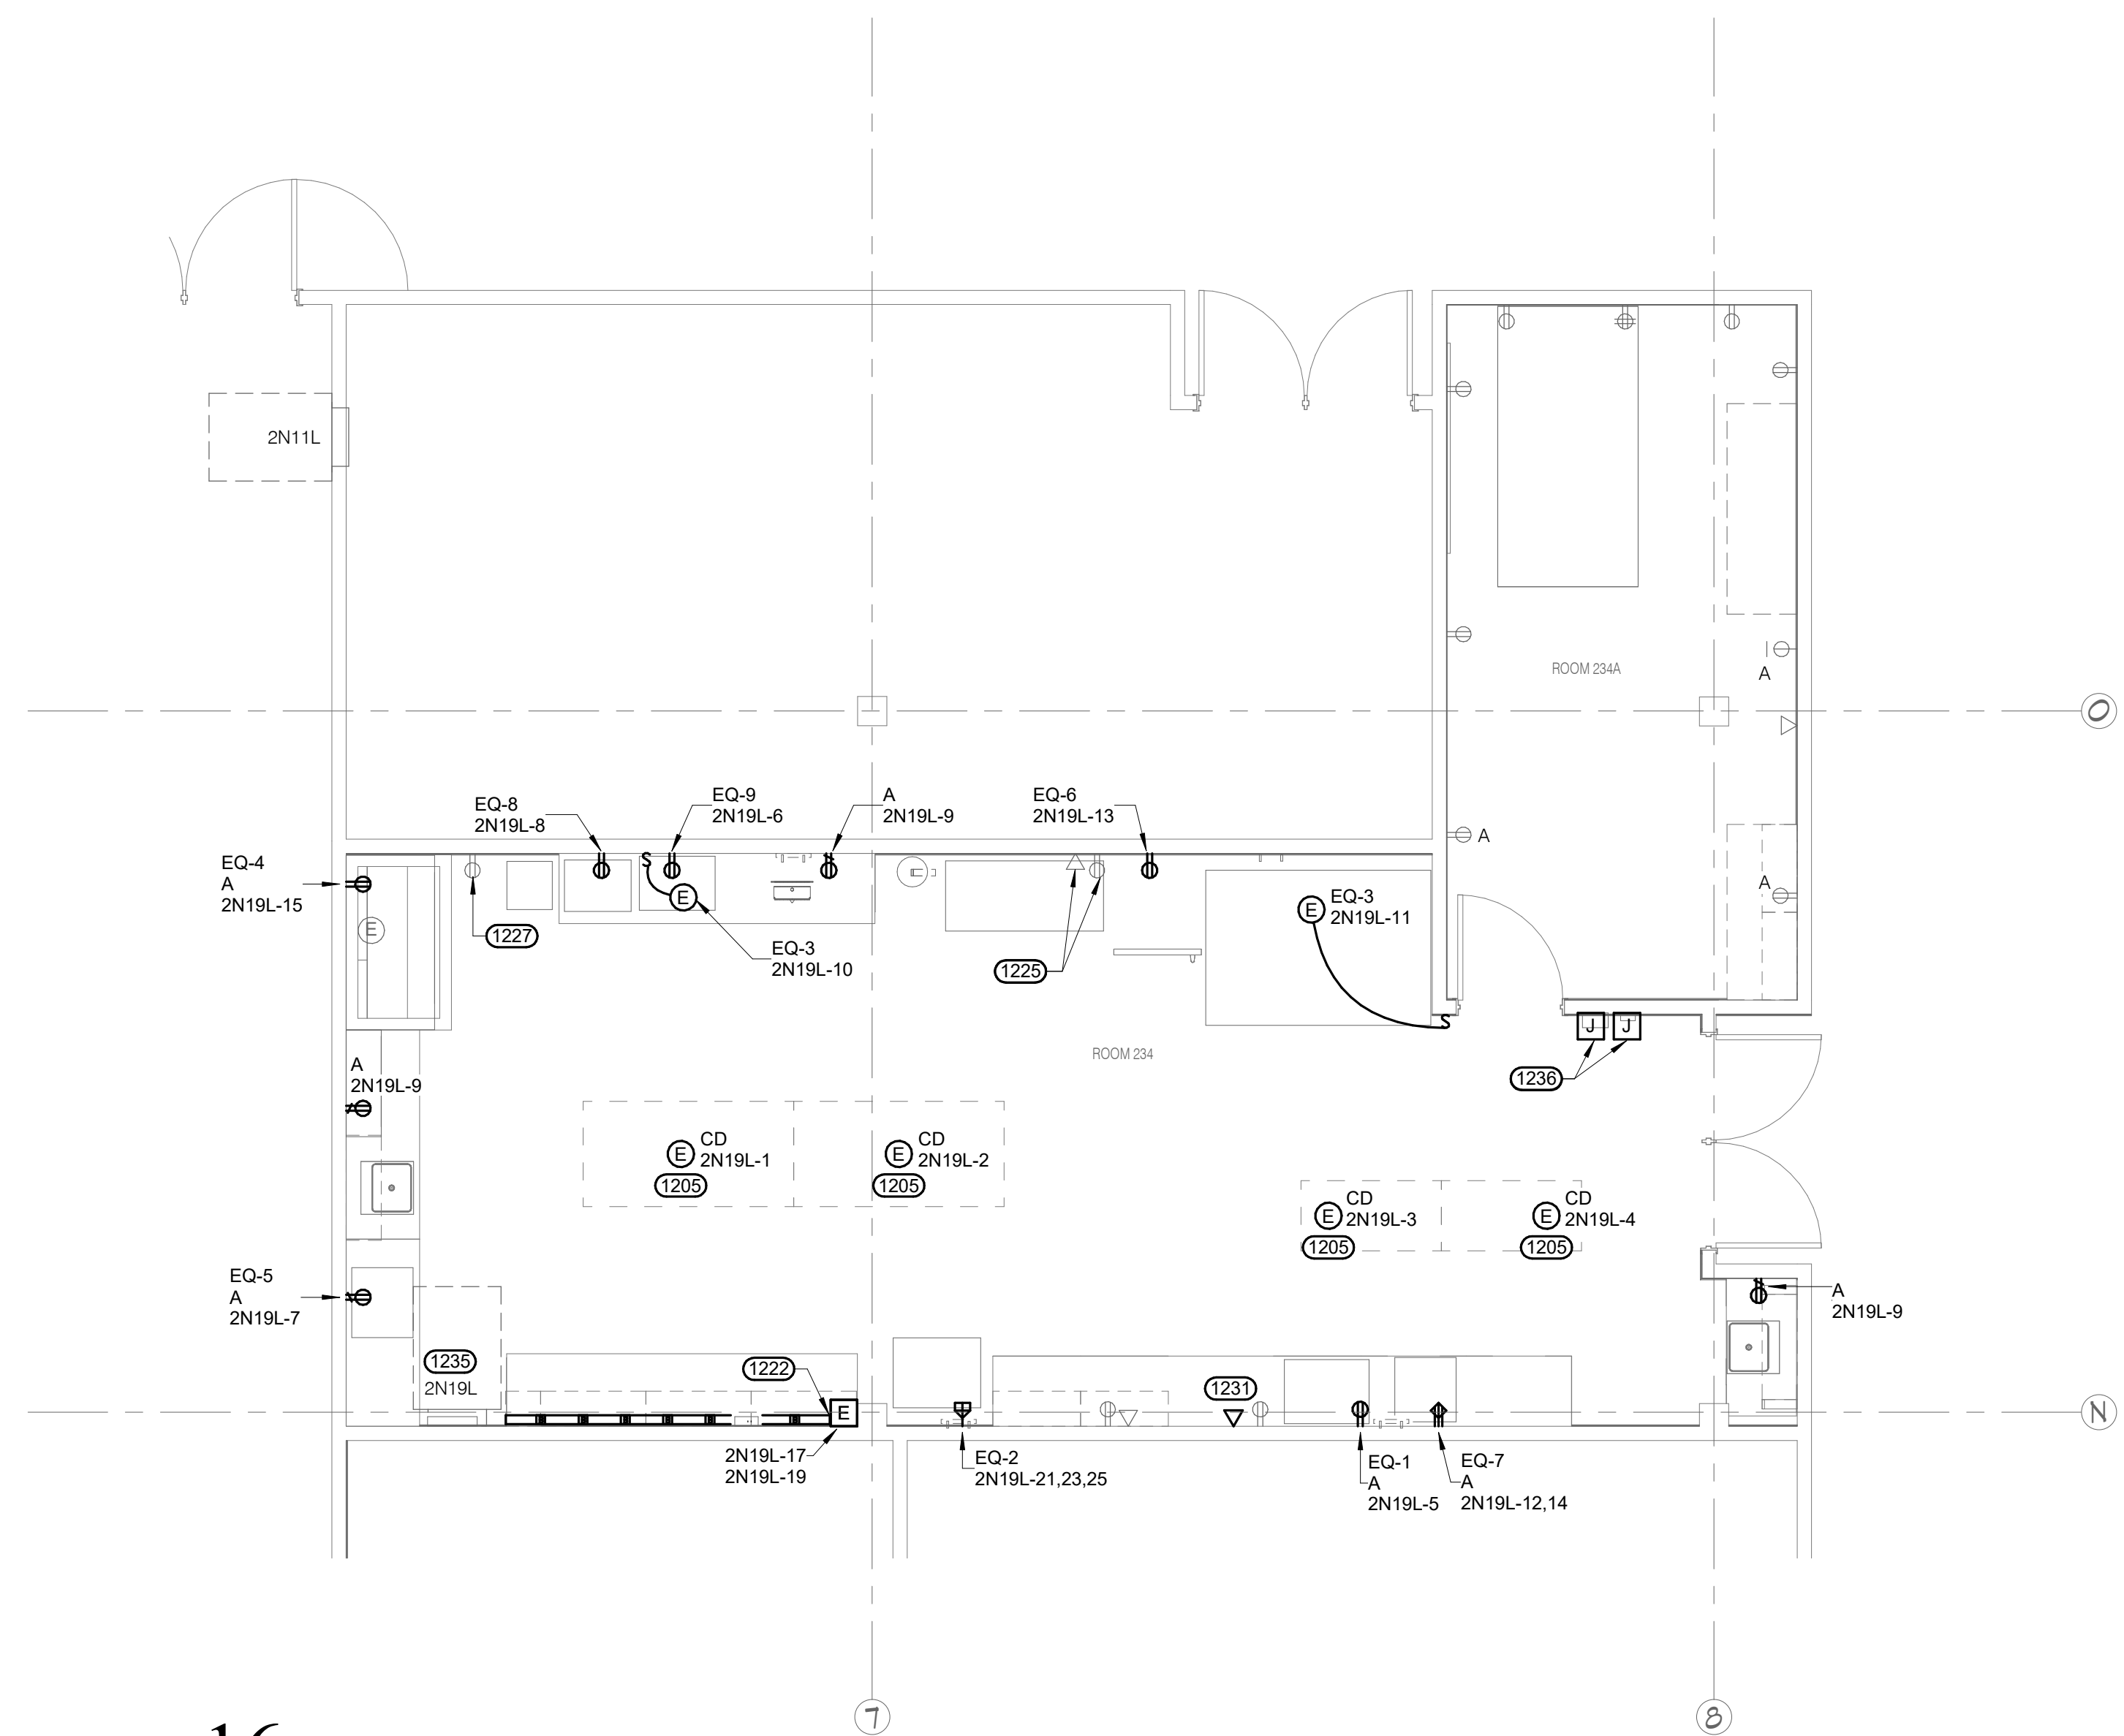

**16 SECOND FLOOR ROOM 234 POWER & SYSTEMS PLAN**  
E2.2 1/4" = 1'-0"

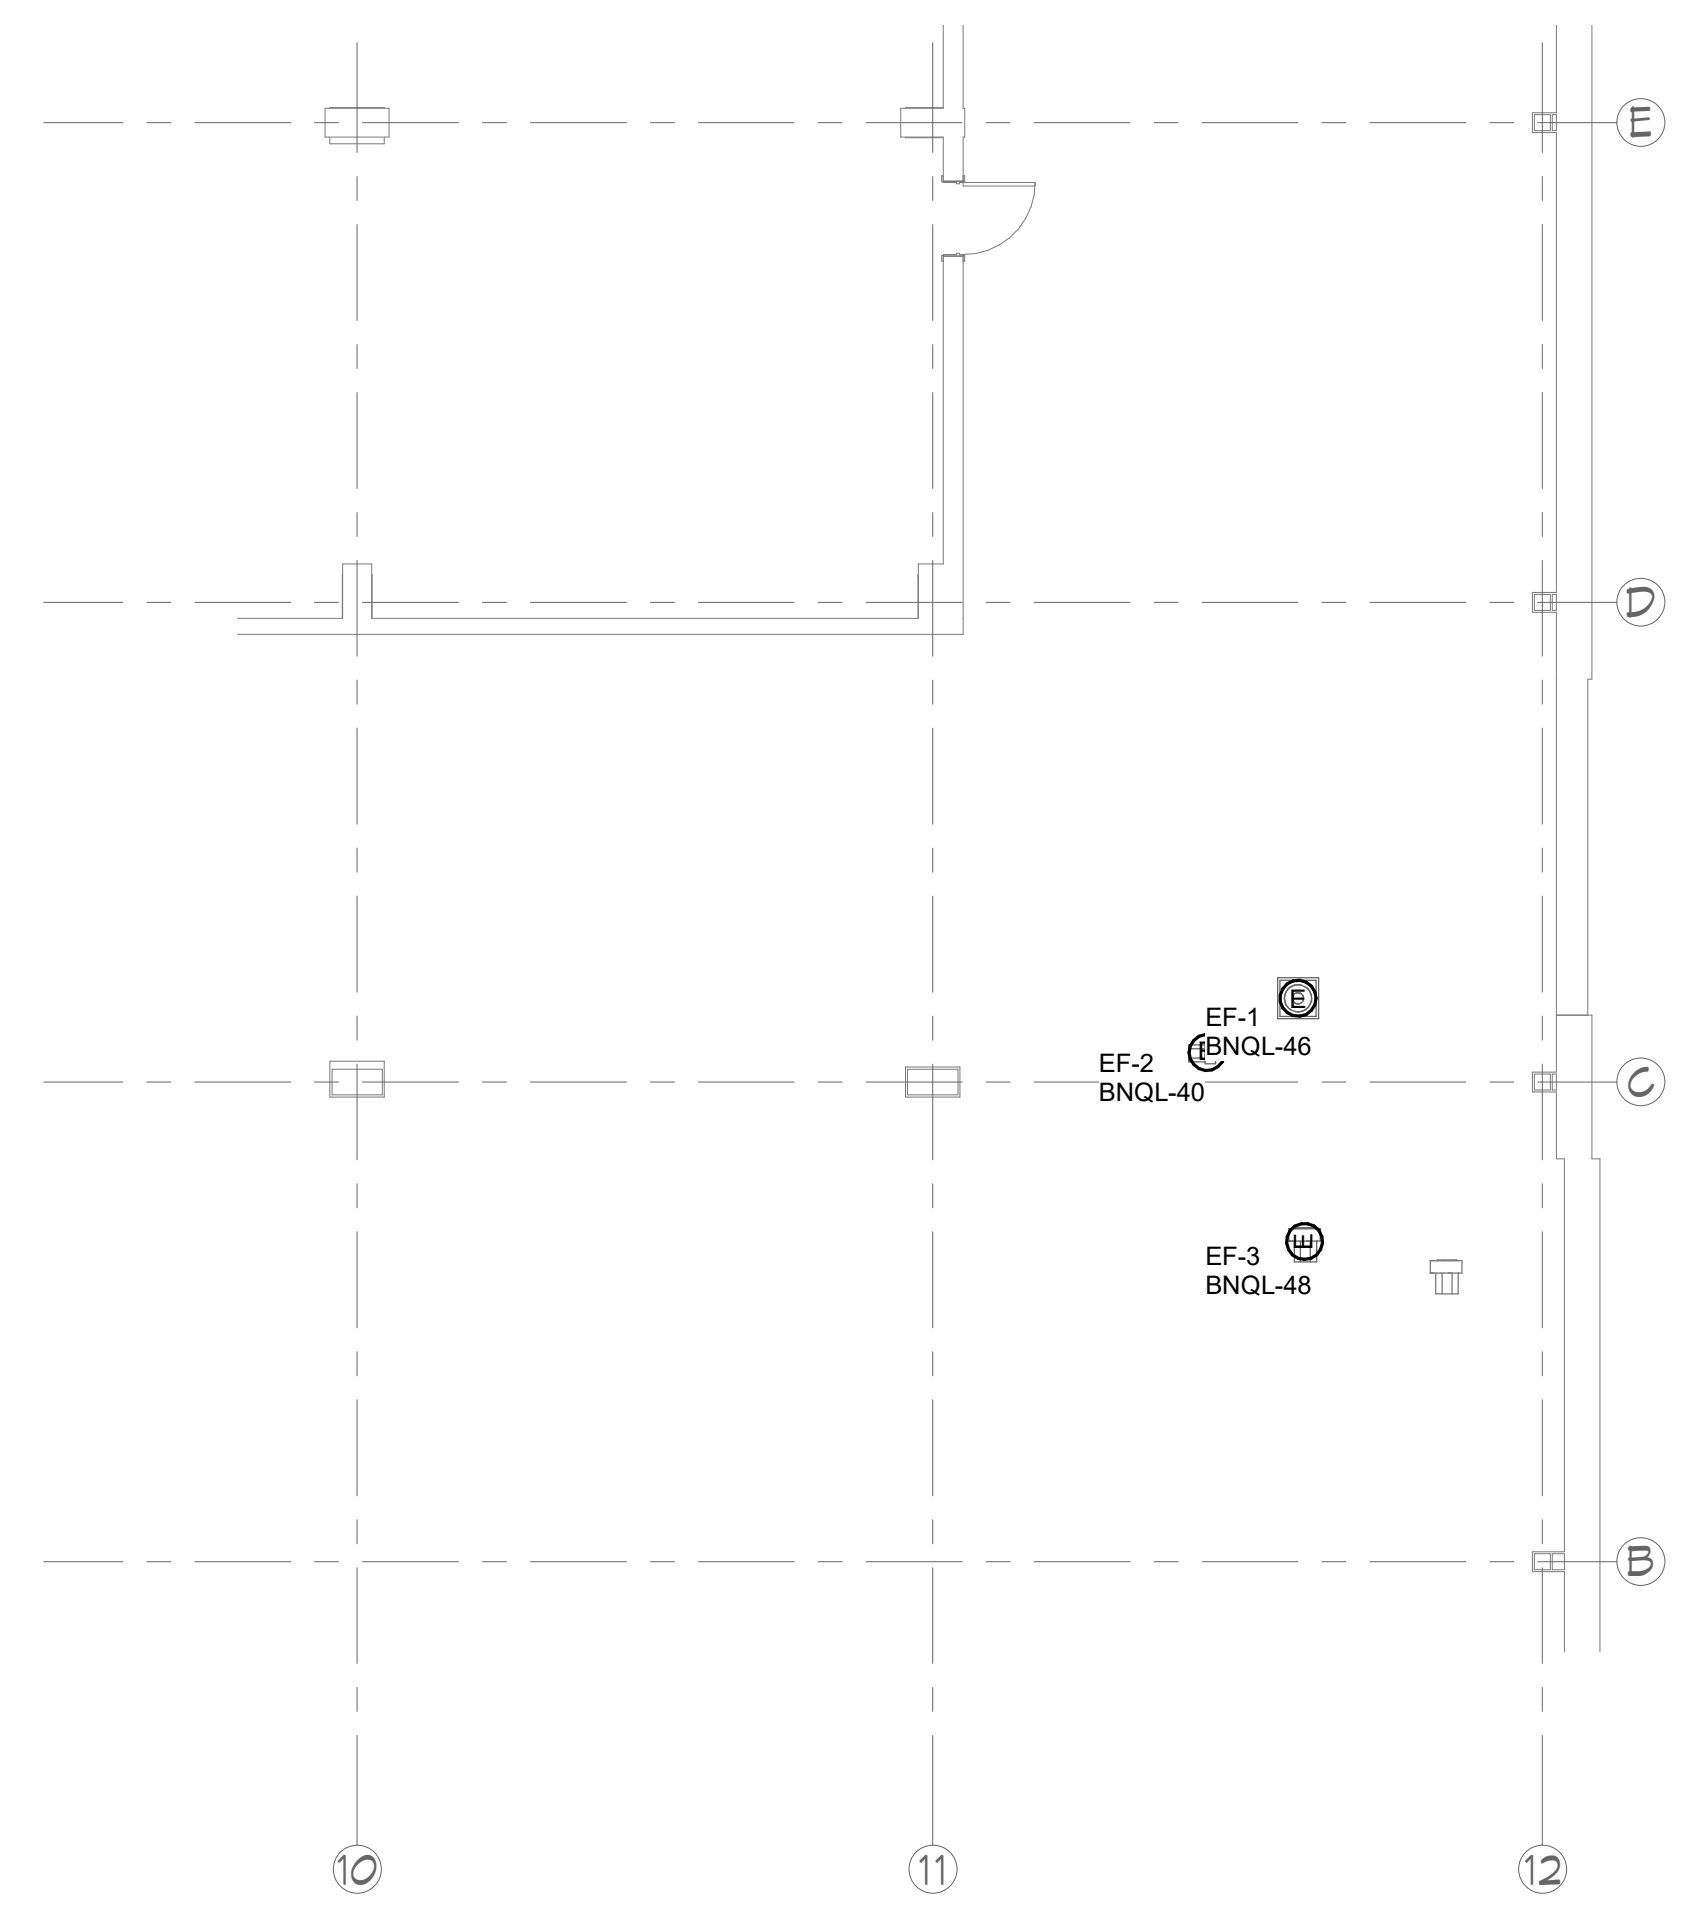

**19 ROOF ELECTRICAL PLAN**  
E2.2 1/8" = 1'-0"

4/18/2024

**IMEG**  
1000 27TH STREET  
BILLYS, MT 59001  
P: 406.256.1141  
WWW.IMEG-CORP.COM

IMEG CORP. RESERVES PROPRIETARY RIGHTS, INCLUDING COPYRIGHTS, IN ALL INFORMATION AND DATA AND THE EXCLUSIVE PROPERTY OF IMEG CORP. AND WILL NOT BE USED FOR ANY OTHER PROJECTS WITHOUT THE WRITTEN PERMISSION AND PARTICIPATION OF IMEG CORP. ©2022 IMEG CORP.  
PROJECT #220870.00  
REF. SCALE IN INCHES


**SECOND FLOOR RM. 234 POWER & SYSTEMS PLAN**  
**BARNARD ROOM 8 QUANTUM FOUNDRY RENOVATION**  
**100% CONSTRUCTION DOCUMENTS**

**HIGH PLAINS**  
ARCHITECTS  
PHONE (406) 896-0250 | FAX (406) 866-0255  
277 E. BOX 2203 | BILLYS, MT 59103  
WWW.HIGHPLAINSARCHITECTS.COM


DRAWN BY: KJC  
PROJECT#: 22210  
DATE: 04/18/2024

**E2.2**

PL01 STAFF: 5/15/2024 11:19:41 AM

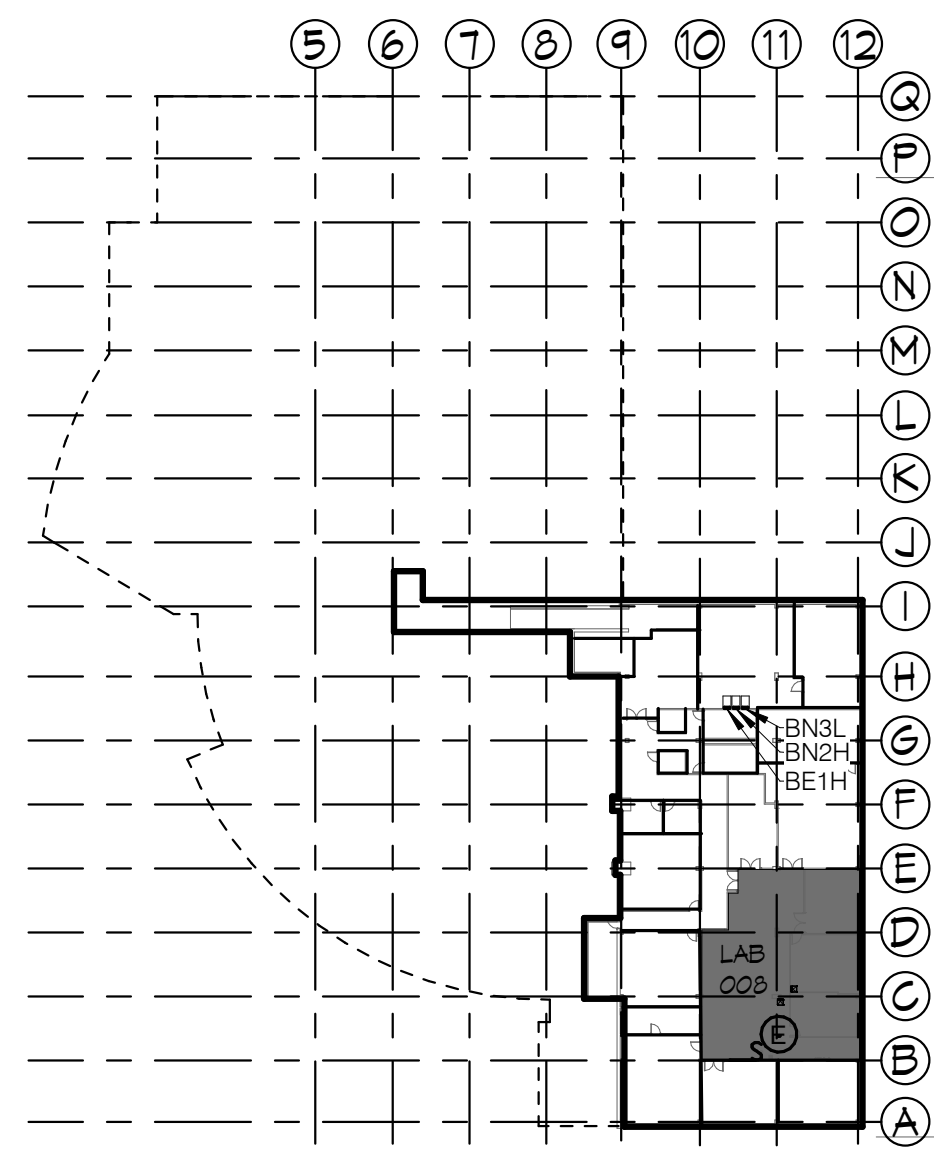

**6** BASEMENT KEY PLAN  
E1.B 1" = 60'-0"

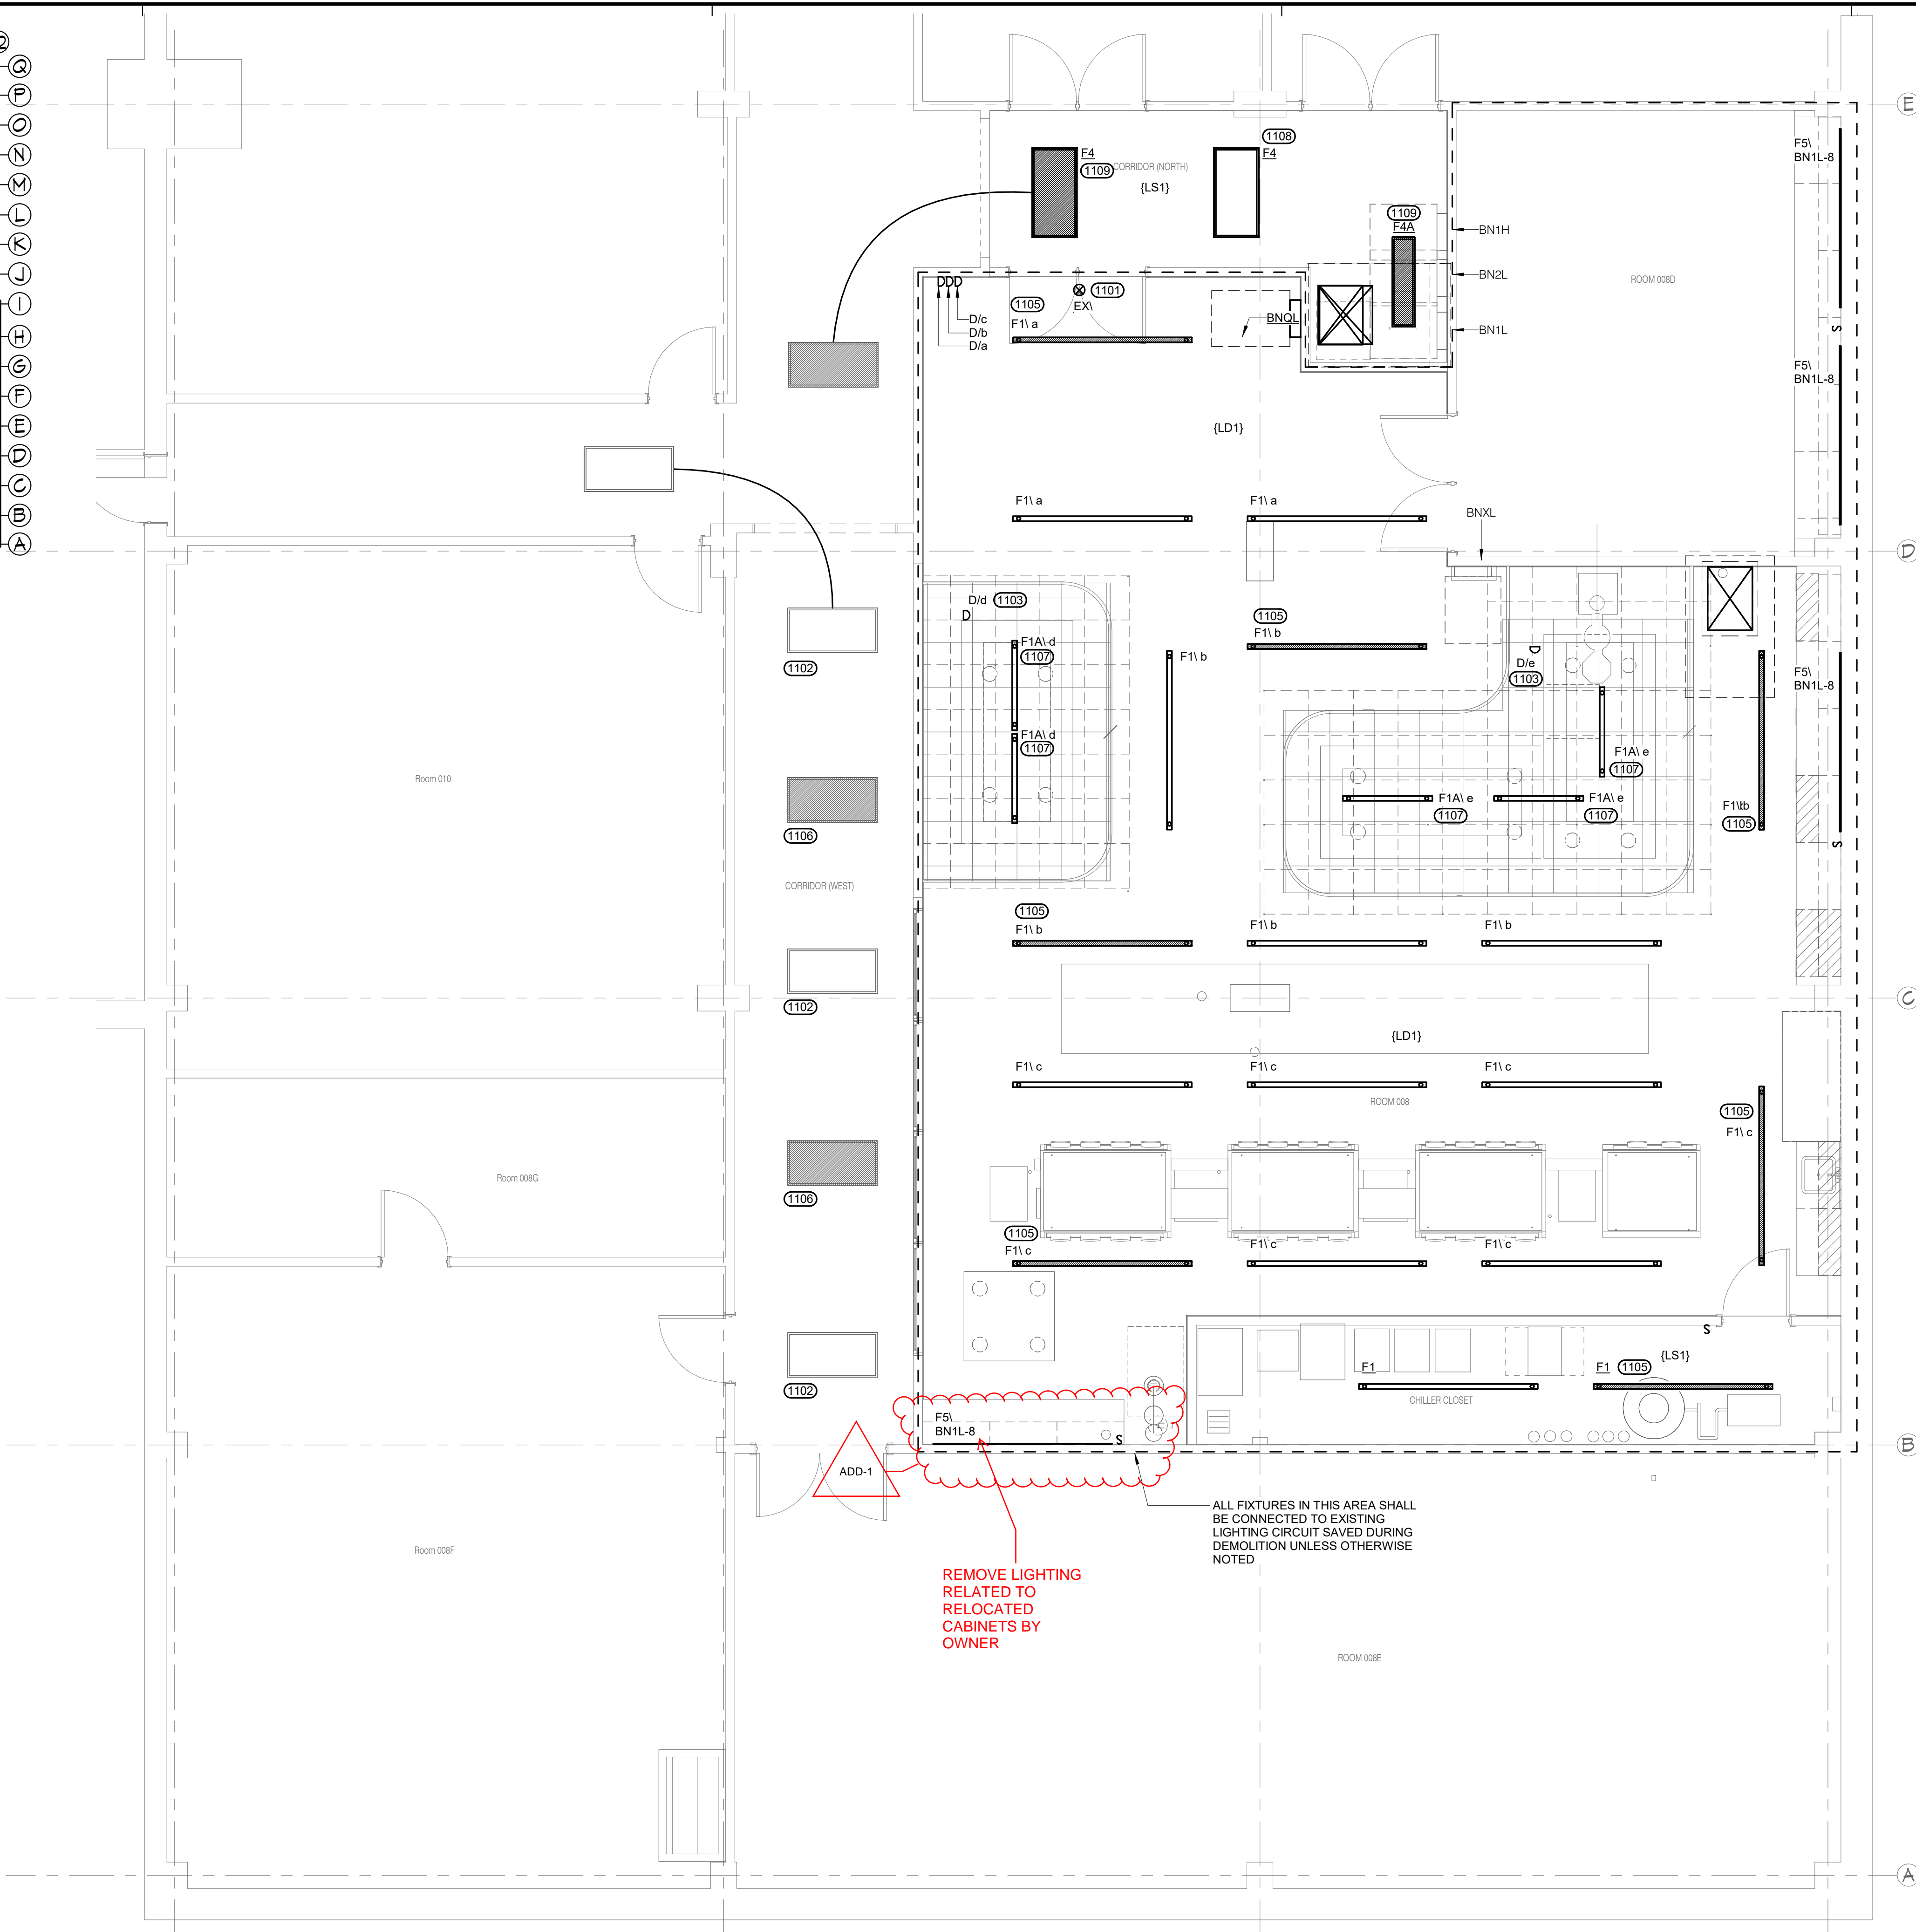

**16** BASEMENT ROOM 008 LIGHTING PLAN  
E1.B 1/4" = 1'-0"

**GENERAL NOTES:**

1. A UL924 DEVICE SHALL BE PROVIDED AT ALL EMERGENCY EGRESS FIXTURES AND SHALL BE SWITCHED WITH LOCAL ROOM NORMAL POWER LIGHTS UNLESS OTHERWISE NOTED.
2. CIRCUIT ALL EXIT SIGNS AND UL924 DEVICE SENSING LEADS AHEAD OF ANY LOCAL SWITCHING.
3. ALL NEW WORK SHALL MATCH EXISTING SEISMIC BRACING AND CODE REQUIREMENTS USED FOR PREVIOUS WORK FOR THIS BUILDING.

**KEYNOTES**

- 1101 REINSTALL EXISTING EXIT SIGN SAVED DURING DEMOLITION.
- 1102 CONNECT EXISTING LUMINAIRE TO EXISTING CORRIDOR LIGHTING CIRCUIT AND CONTROL.
- 1103 PROVIDE SENSOR SWITCH SPDMRA JOT WIRELESS DIMMER OR APPROVED EQUIVALENT FOR F1A FIXTURES. LOCATE ON UNDERSIDE ON TABLE.
- 1105 CONNECT NEW LUMINAIRE AS NOTED TO EXISTING EMERGENCY LIGHTING CIRCUIT SAVED DURING DEMOLITION.
- 1106 RECONNECT EXISTING LUMINAIRE TO EXISTING EMERGENCY LIGHTING CIRCUIT SERVING CORRIDOR. FIXTURE SHALL BE CONTROLLED WITH EXISTING CORRIDOR LIGHTING.
- 1107 FIXTURE F1A TO BE MOUNTED TO THE UNDERSIDE OF OVERHEAD SHELVING. LUMINAIRE TO BE SUSPENDED AT 76" A.F.F. COORDINATE ROUTING FOR POWER TO LUMINAIRE WITH OWNER AND MILLWORK CONTRACTOR.
- 1108 CONNECT NEW LUMINAIRE TO EXISTING CORRIDOR LIGHTING CIRCUIT AND CONTROL.
- 1109 CONNECT NEW LUMINAIRE TO EMERGENCY LIGHTING CIRCUIT AND CONTROL SERVING CORRIDOR.

4/18/2024

**IMEG**  
175N 27TH STREET  
BILLYUNG, MT 59011  
P: 409.256.1141  
WWW.PROJECT302.COM

IMEG CORP. RESERVES PROPRIETARY RIGHTS, INCLUDING COPYRIGHTS, IN ALL INFORMATION AND DATA AND THE EXCLUSIVE PROPERTY OF IMEG CORP. AND WILL NOT BE USED FOR ANY OTHER PROJECTS WITHOUT THE WRITTEN PERMISSION AND PARTICIPATION OF IMEG CORP. ©2022 IMEG CORP. PROJECT #2208970.00  
REF. SCALE IN INCHES

**BASEMENT ROOM 008 LIGHTING PLAN**  
**BARNARD ROOM 8 QUANTUM FOUNDRY RENOVATION**  
**100% CONSTRUCTION DOCUMENTS**

**HIGH PLAINS**  
**ARCHITECTS**  
PHONE: (409) 896-0250 | FAX: (409) 896-0255  
277 S. BOX 2203 | BILLYUNG, MT 59103  
WWW.HIGHPLAINSARCHITECTS.COM

DRAWN BY: KJC  
PROJECT#: 22210  
DATE: 04/18/2024

**E1.B**

PLOT STAMP: 5/15/2024 11:19:46 AM